### ARCHITECT

PETER PAPADOPOULOS
SMITH AND MOORE ARCHITECTS, INC
1500 SOUTH OLIVE AVENUE
WEST PALM BEACH, FLORIDA 33401
(561) 835-1888

### LANDSCAPE ARCHITECT

DUSTIN MIZELL / LAUREN FREEMAN
ENVIRONMENT DESIGN GROUP
139 NORTH COUNTY ROAD, SUITE #20-B
PALM BEACH, FLORIDA 33480
(561) 832-4600

### CIVIL ENGINEER

CHAD GRUBER
GRUBER CONSULTING ENGINEERS
247 MERCER AVENUE
WEST PALM BEACH, FLORIDA 33401
(561) 312-2041

### SURVEYING

CRAIG WALLACE
WALLACE SURVEYING CORP.
5553 VILLAGE BOULEVARD
WEST PALM BEACH, FLORIDA 33407
(561) 640-4551

RECEIVED

By yfigueroa at 1:53 pm, May 08, 2023

# ARC - 22 - 240

DEFERRAL FROM ARCOM HEARING 01/25/2023

# DROP-OFF SUBMITTAL 05/08/2023

## ARCOM HEARING 05/24/2023

# 1198 N. OCEAN WAY, PALM BEACH, FLORIDA

SCOPE OF WORK:

CONSTRUCTION OF A NEW TWO- STORY SINGLE-FAMILY RESIDENCE WITH RELATED LANDSCAPE AND HARDSCAPE IMPROVEMENTS.

SHEET INDEX									
e	Sheet Title	Page Sheet Title		Sheet Title					
	Cover Page		Building Cross-Section	BS-1	Site Grading & Drainage	C-1			
	Vicinity Location Map SV-1		Site Plan Overlay	SP-4	Staging, Parking & Erosion Control	EC-1			
	Aerial View SV-1a		Calculated Lot Depth	SP-LD	Site Staging & Logistics Plan				
	Location Plan SV-2				Construction Schedule				
	Neighborhood Photo Sheets P-1/P-2		Existing Site Images	L1.0					
	Neighborhood Photo Sheet P-3/P-4		Existing Vegetation Inventory	L2.0					
	Wallace Survey		Demo. & Vegetation Action Plan	L3.0					
			Construction Screening Plan	L4.0					
	Site Plan & Site Walls Details SP-1 previous		Color Site Plan	L7.0					
	Site Plan & Site Wall Details SP-1		Site Calculations	L7.1					
	Site Zoning Plan & Site Wall Detail SP-2		Landscape Plan	L8.0					
	Site Zoning Legend SP-3		Rendered Landscape Plan	L8.1					
	Floor Plans & Roof Plan FP-1/FP-2 previous		Plant Schedule	L8.2					
	Floor Plans & Roof Plan FP-1/FP-2		Planting Details	L8.3					
	Previous & Proposed Elevs. EL-1/EL-2		Landscape Lighting Plan	L9.0					
	Previous & Proposed Elevs. EL-3/ EL-4		Rendered Landscape Elevs.	L10.0/ L10.1					
	Renderings R-1/ R-2/ R-3/ R-4								
	Architectural Details DT-1/ DT-2								
	Streetscape Elevations SV-3/ SV-4								



MITH AND MOORE ARCHITECTS, INC.

FLORIDA AAC NO. 001285

HAROLD J. SMITH REGISTERED ARCHITECT 8742

PETER G. PAPADOPOULOS REGISTERED ARCHITECT 92952

JONATHAN C. MOORE REGISTERED ARCHITECT 13541

DANIEL KAHAN
REGISTERED ARCHITECT 92952

 SCHEM. DESIGN
 2022-08-08

 SCHEM. DESIGN
 2022-08-26

 PRE-APP SUBMITTAL
 2022-09-19

 FIRST SUBMITTAL
 2022-11-07

 SECOND SUBMITTAL
 2022-11-28

 DROP-OFF SUBMITTAL
 2022-12-09

 DESIGN DEVELOP.
 2023-041-07

 DROP-OFF SUBMITTAL
 2023-05-08

NO: 22026 DWG. BY: PGP SHEET:

ARCOM # ARC - 22 -240
S 0 0 2





NO. 001285 HAROLD J. SMITH REGISTERED ARCHITECT 8742

JONATHAN C. MOORE REGISTERED ARCHITECT 13541

PETER G. PAPADOPOULOS REGISTERED ARCHITECT 92952 DANIEL KAHAN

REGISTERED ARCHITECT 94757

PRE-APP SUBMITTAL 2022-09-1 FIRST SUBMITTAL 2022-11-07 DROP-OFF SUBMITTAL 2022-12-09 DESIGN DEVELOP. 2023-041-07 DROP-OFF SUBMITTAL 2023-05-08


NO: 22026 DWG. BY: PGP SHEET:

NOT TO SCALE

SV-1

VICINITY LOCATION MAP



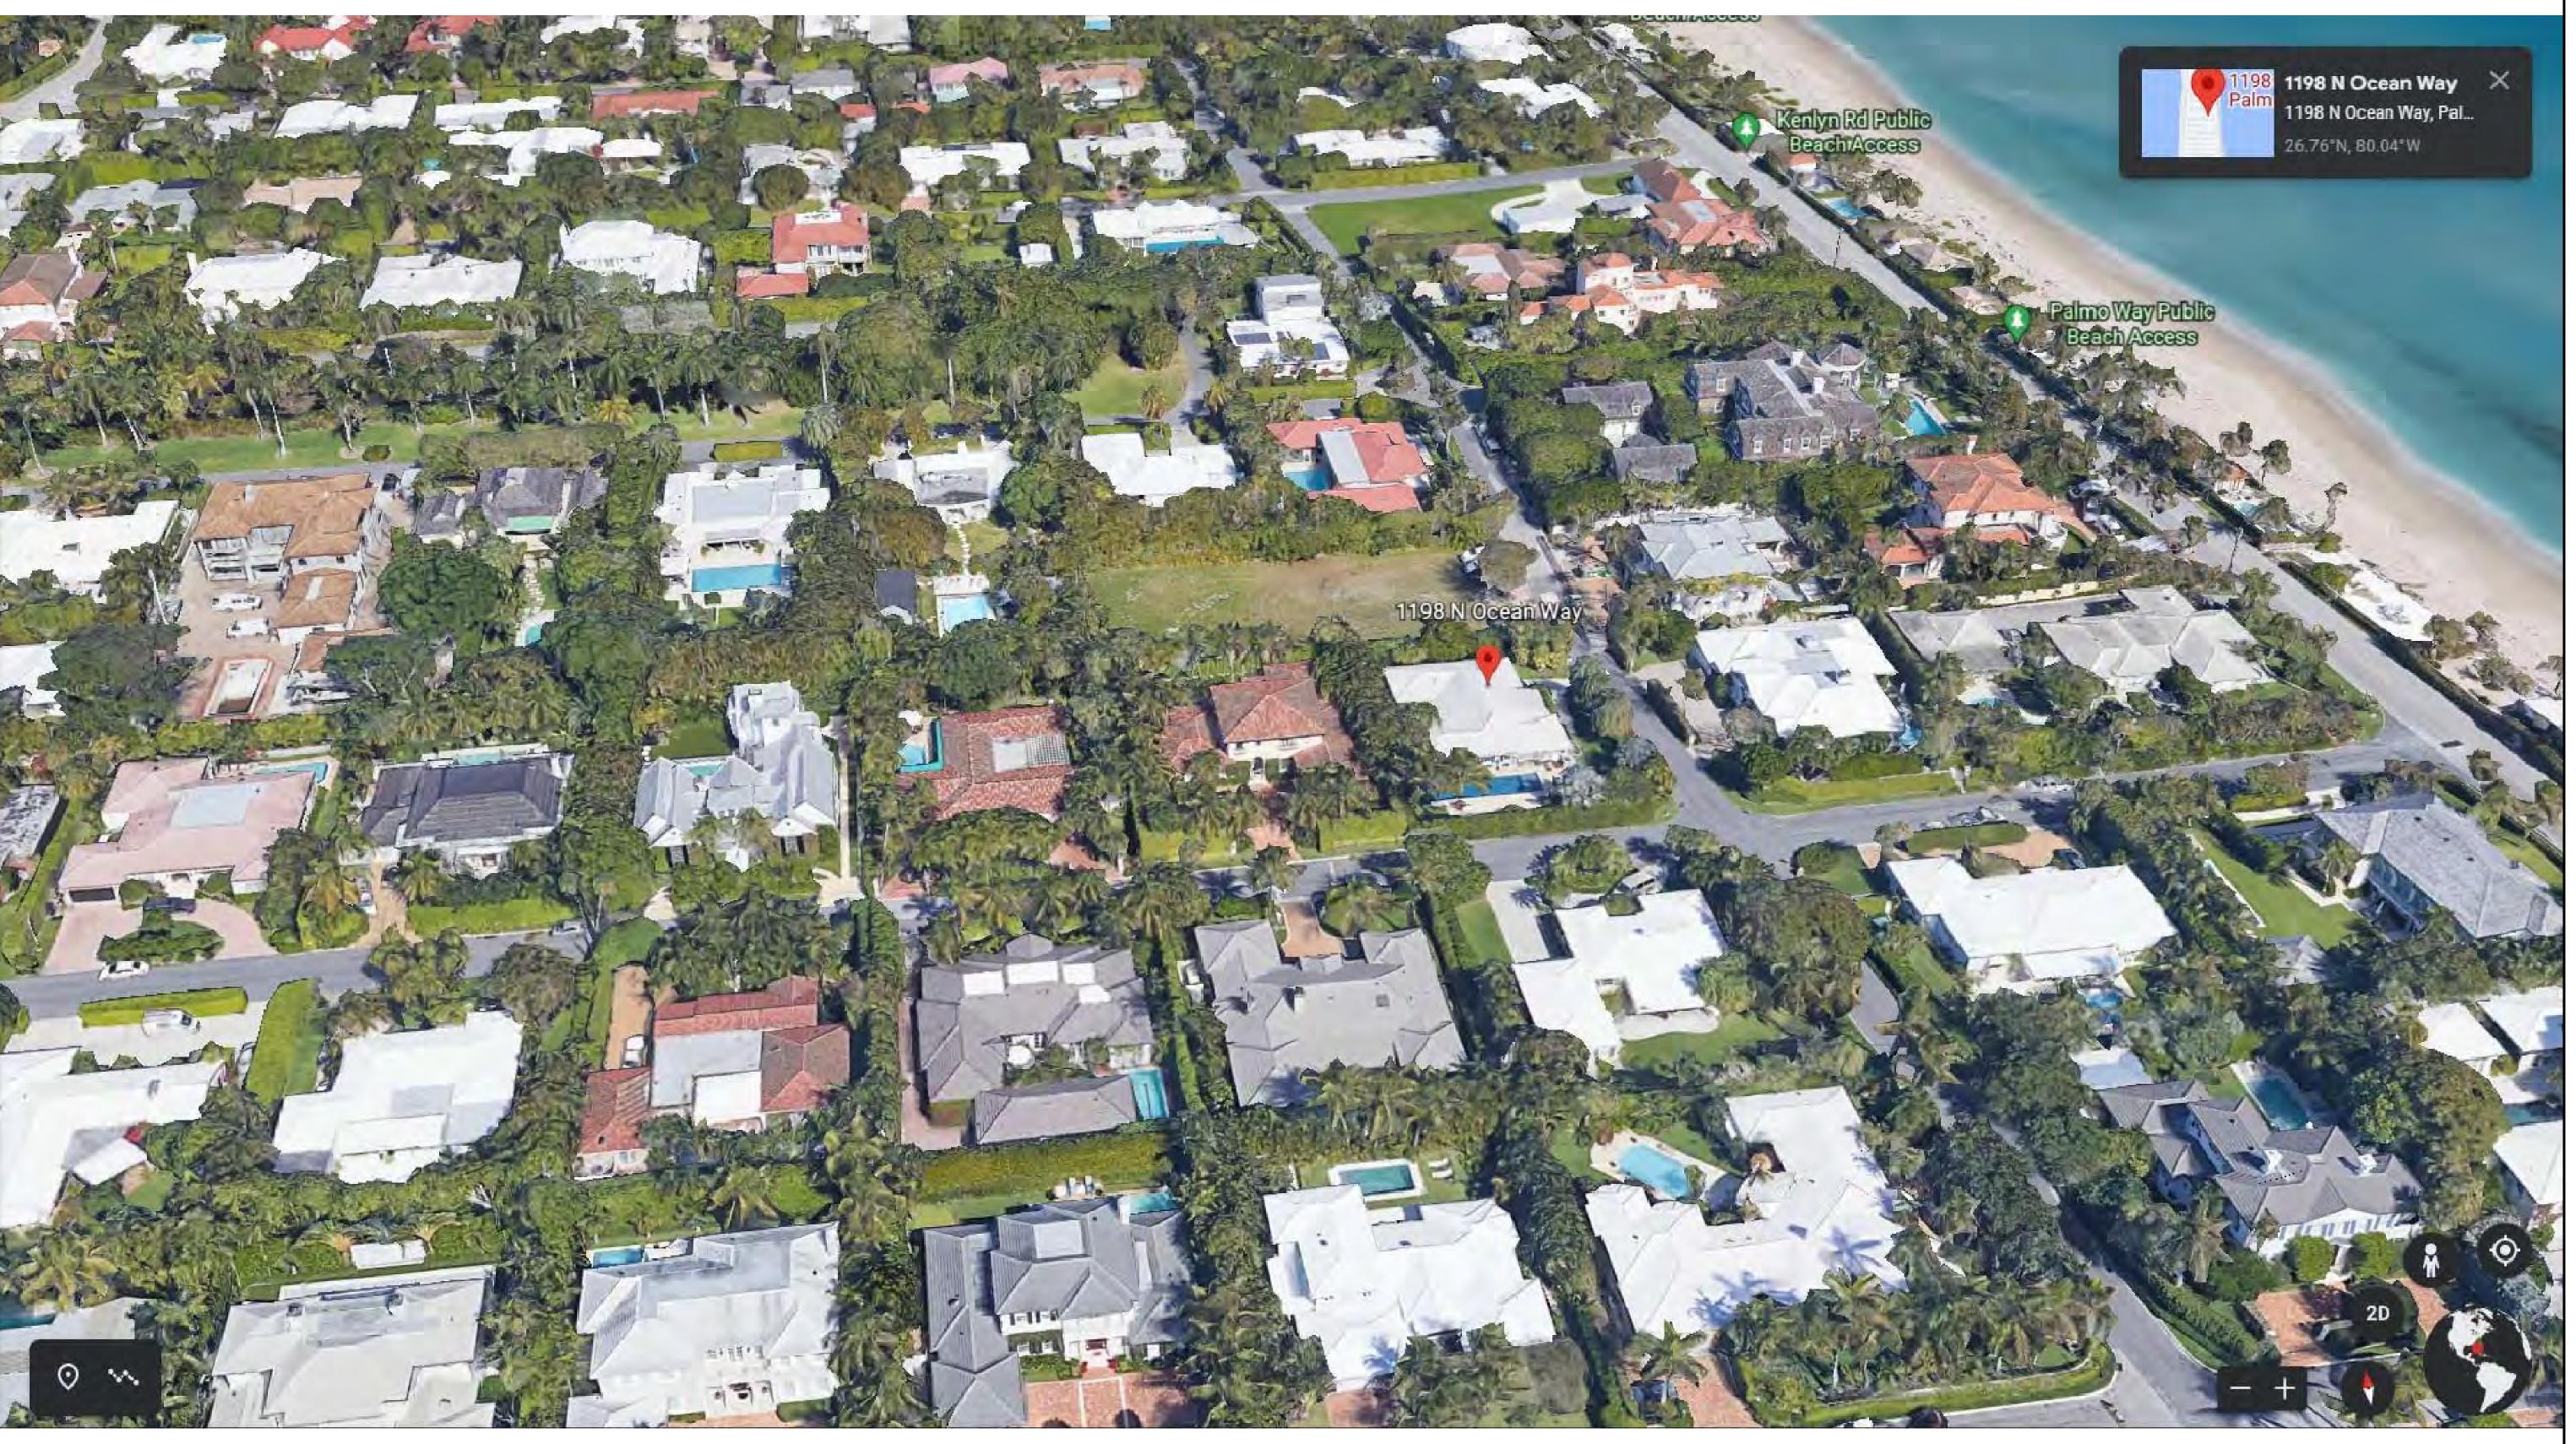

SCHEM. DESIGN 2022-08-08 SCHEM. DESIGN 2022-08-26 PRE-APP SUBMITTAL 2022-09-19 FIRST SUBMITTAL 2022-11-07 SECOND SUBMITTAL 2022-11-28 DROP-OFF SUBMITTAL 2022-12-09 DESIGN DEVELOP. 2023-041-07 DROP-OFF SUBMITTAL 2023-05-08

NO: 22026
DWG. BY: PGP
SHEET:

SV-1a

FLORIDA AAC

NO. 001285


HAROLD J. SMITH REGISTERED ARCHITECT 8742

JONATHAN C. MOORE REGISTERED ARCHITECT 13541


PETER G. PAPADOPOULOS REGISTERED ARCHITECT 92952

DANIEL KAHAN REGISTERED ARCHITECT 94757

1198 N OCEAN WAY - AERIAL VIEW
NOT TO SCALE

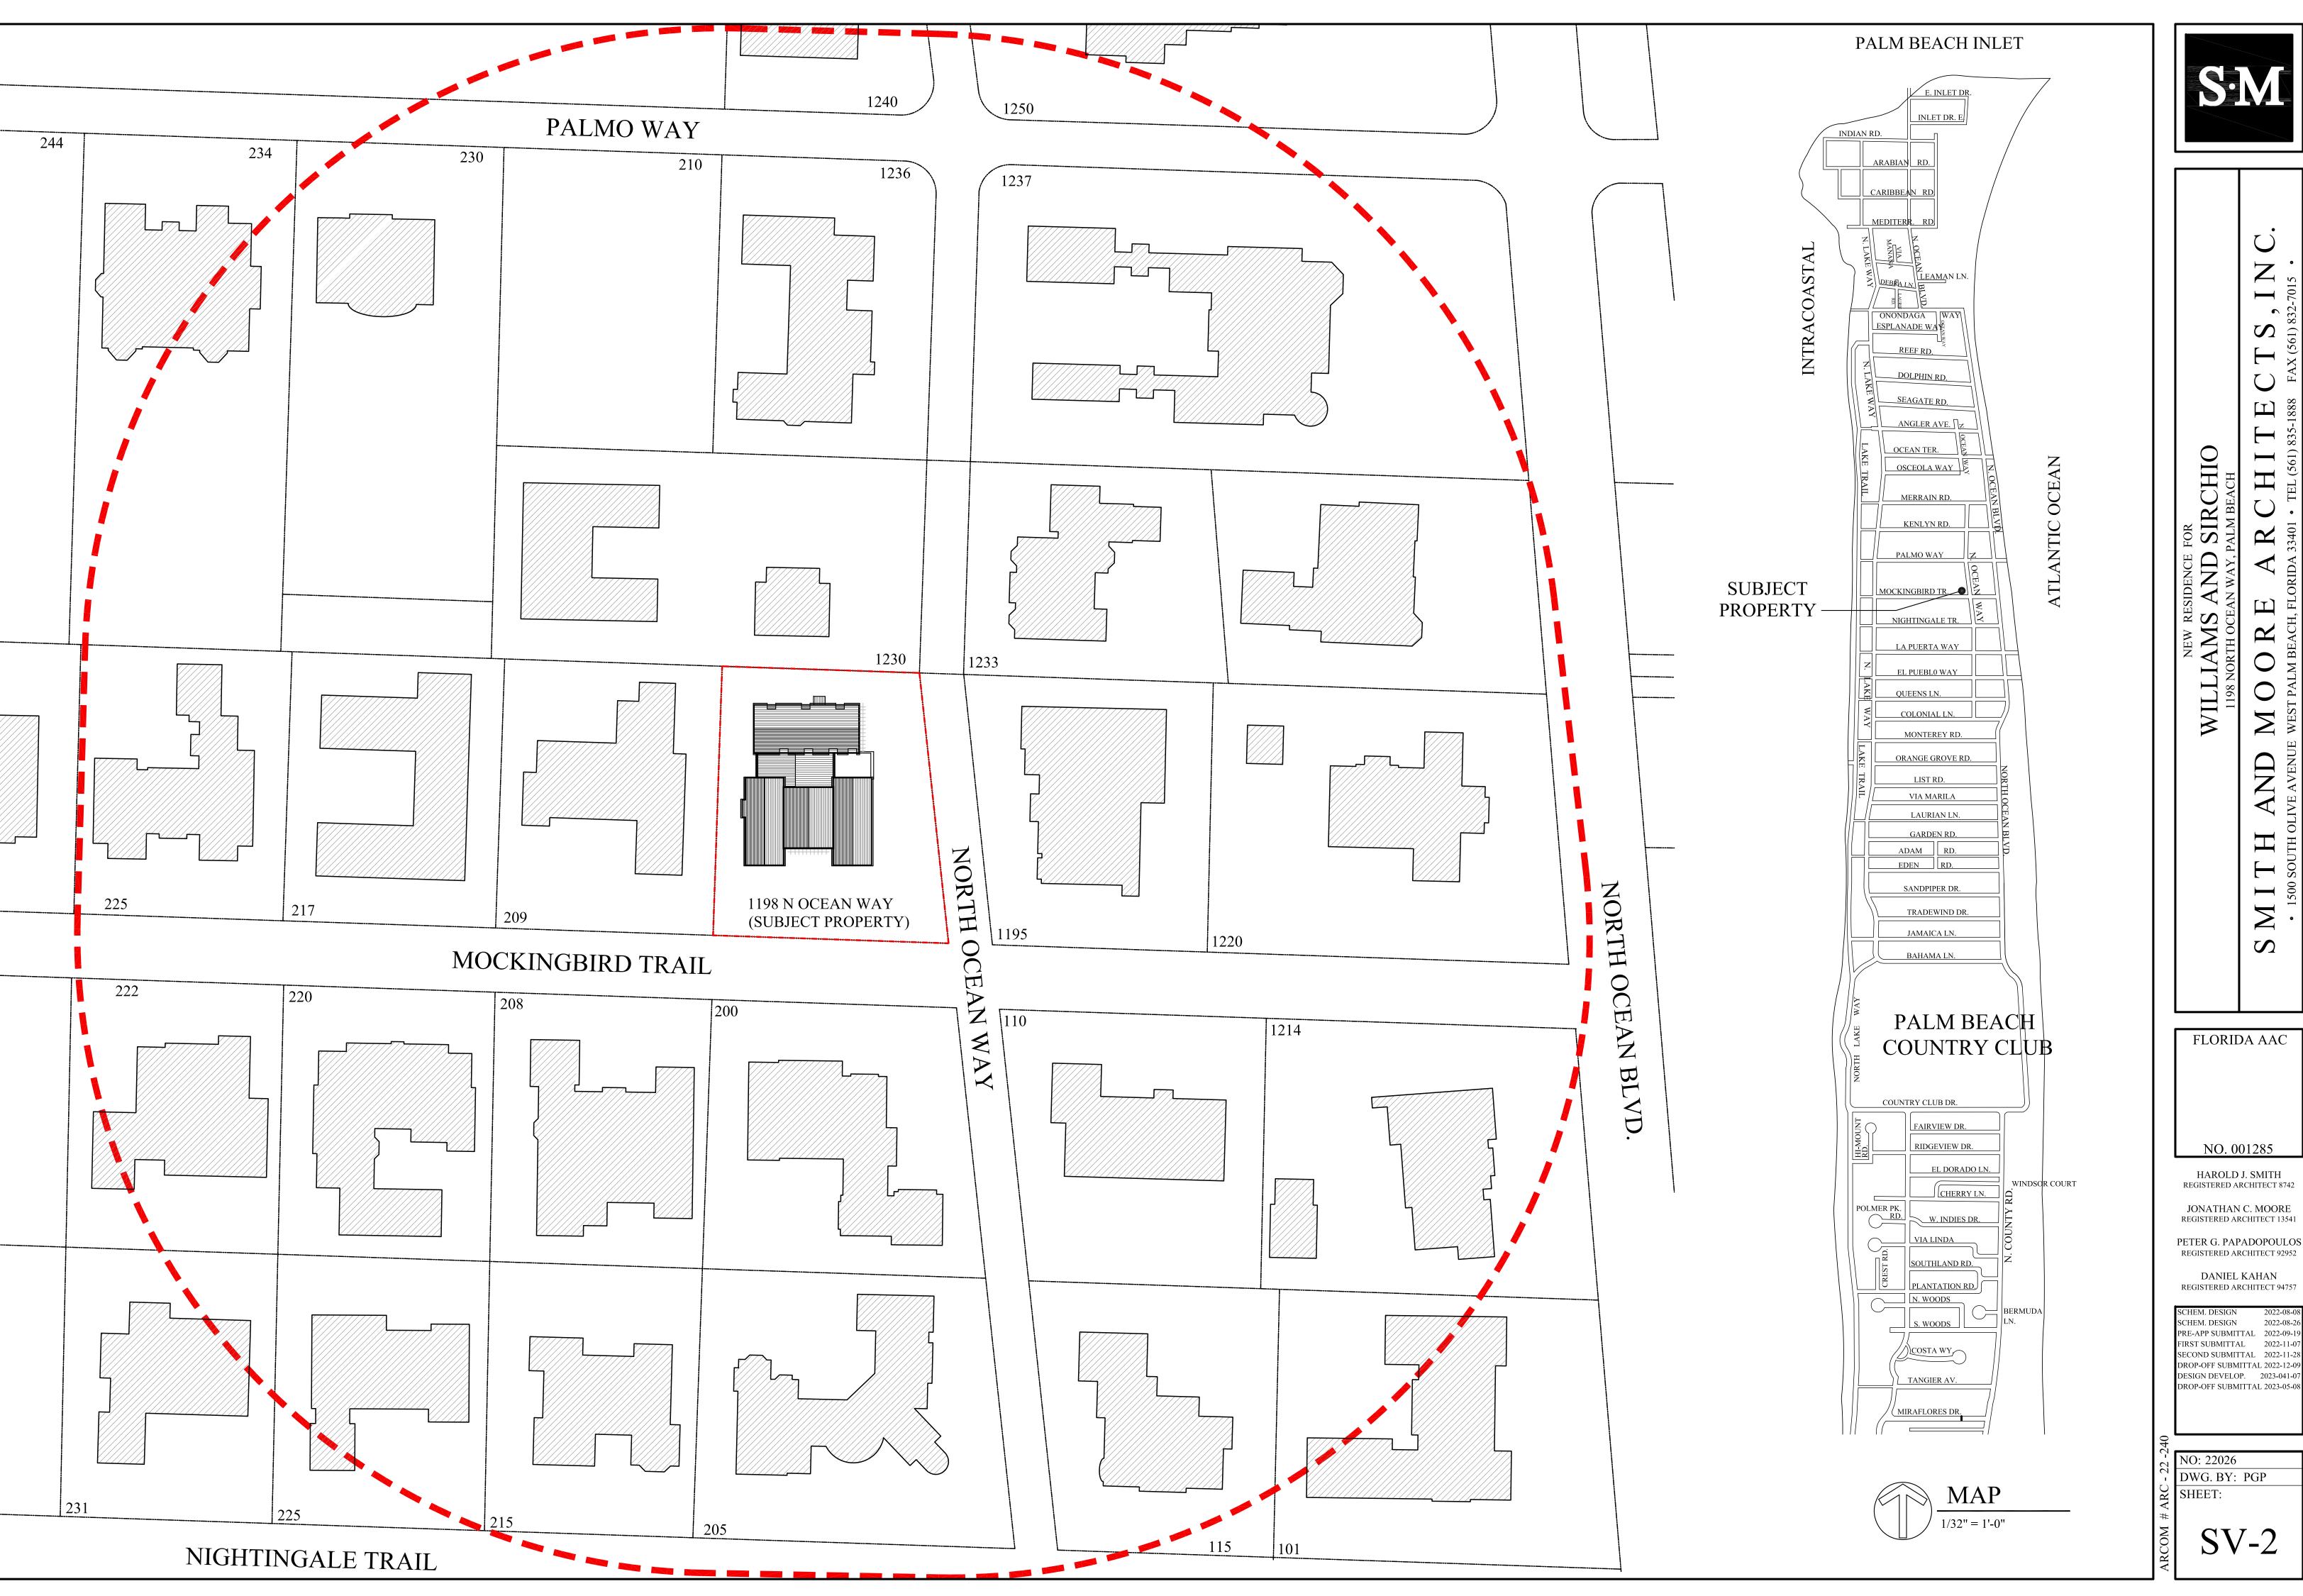

REGISTERED ARCHITECT 92952

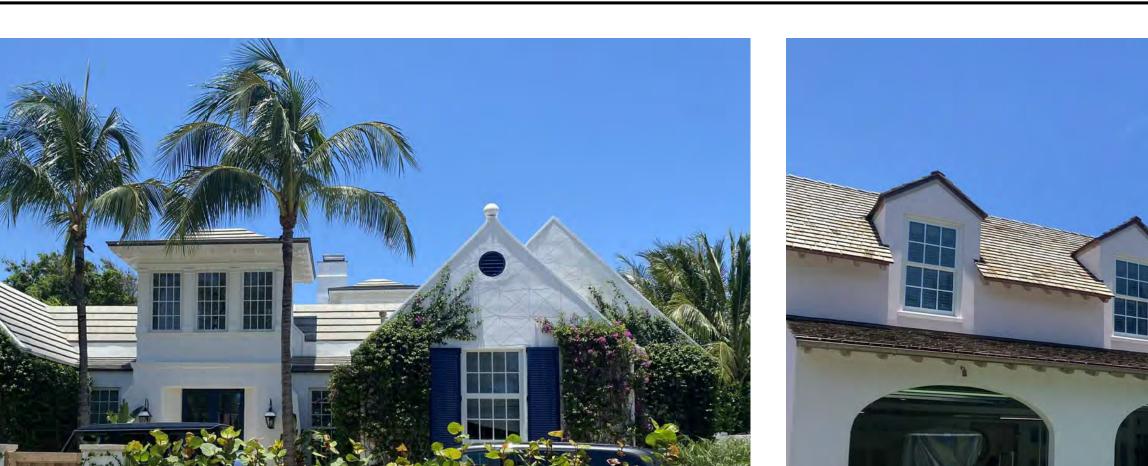




217 MOCKINGBIRD TRAIL



209 MOCKINGBIRD TRAIL

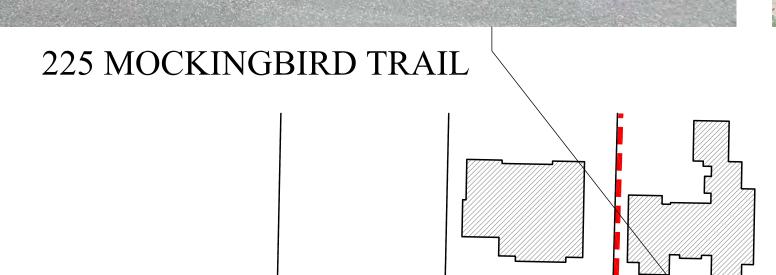

1198 N OCEAN WAY (SUBJECT PROPERTY) MOCKINGBIRD TRAIL



1198 N OCEAN WAY (SUBJECT PROPERTY)

1195 N OCEAN WAY

1220 N OCEAN BLVD

FLORIDA AAC

NO. 001285 HAROLD J. SMITH REGISTERED ARCHITECT 8742

DESIGN DEVELOP. 2023-041-07 DROP-OFF SUBMITTAL 2023-05-08

NO: 22026 DWG. BY: PGP

P-1








1214 N OCEAN BLVD 110 MOCKINGBIRD TRAIL 1198 N OCEAN WAY (SUBJECT PROPERTY) MOCKINGBIRD TRAIL

200 MOCKINGBIRD TRAIL





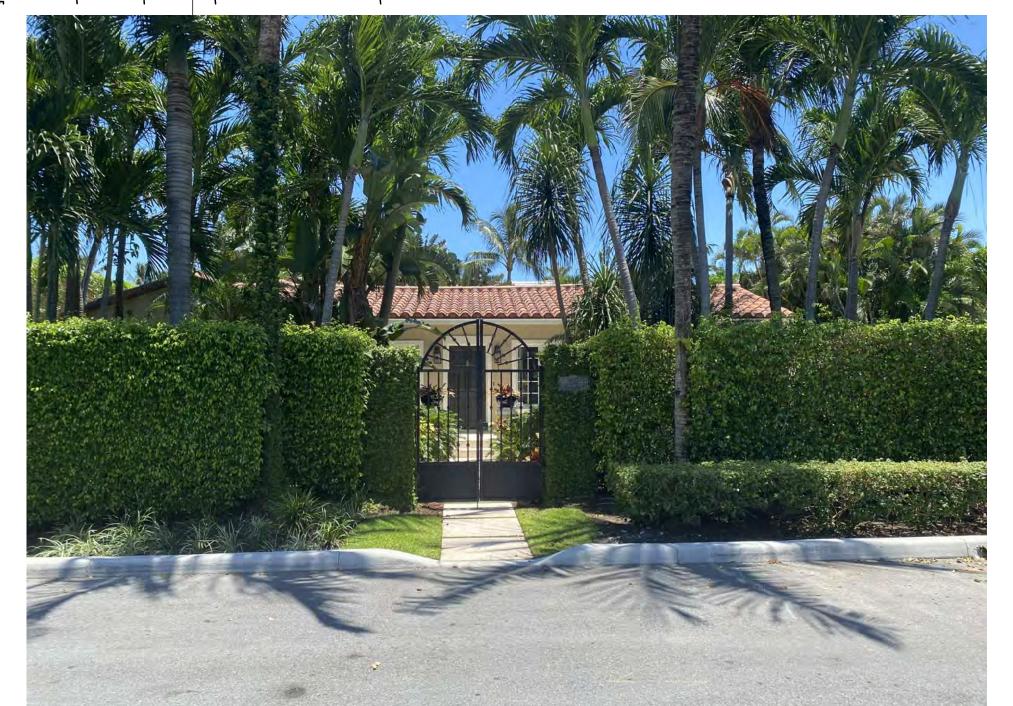

222 MOCKINGBIRD TRAIL 208 MOCKINGBIRD TRAIL 220 MOCKINGBIRD TRAIL

FLORIDA AAC

NO. 001285

HAROLD J. SMITH REGISTERED ARCHITECT 8742

PETER G. PAPADOPOULOS REGISTERED ARCHITECT 92952

DANIEL KAHAN REGISTERED ARCHITECT 94757

DESIGN DEVELOP. 2023-041-07 DROP-OFF SUBMITTAL 2023-05-08

NO: 22026 DWG. BY: PGP

SHEET:




205 NIGHTINGALE TRAIL



200 MOCKINGBIRD TRAIL



1198 N OCEAN WAY

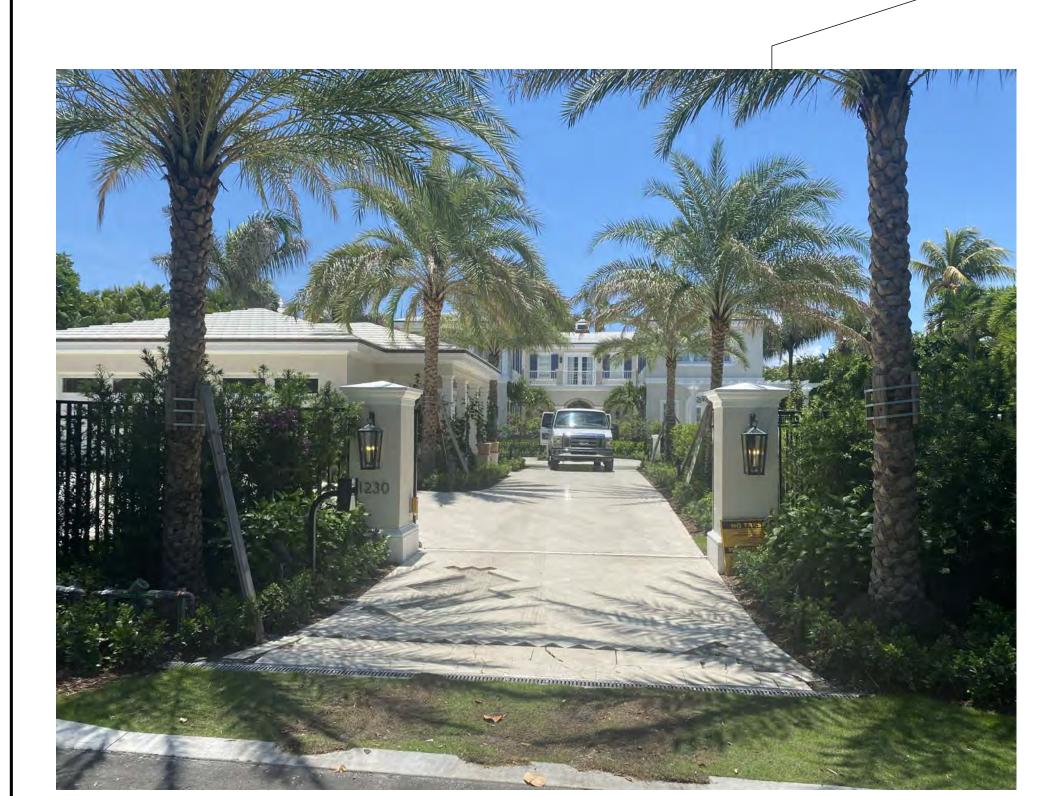

1230 N OCEAN WAY



1236 N OCEAN WAY

NO. 001285

HAROLD J. SMITH REGISTERED ARCHITECT 8742 JONATHAN C. MOORE

PETER G. PAPADOPOULOS REGISTERED ARCHITECT 92952


REGISTERED ARCHITECT 13541

DANIEL KAHAN REGISTERED ARCHITECT 94757

DROP-OFF SUBMITTAL 2022-12-09 DESIGN DEVELOP. 2023-041-07 DROP-OFF SUBMITTAL 2023-05-08

SHEET:

NO: 22026 DWG. BY: PGP

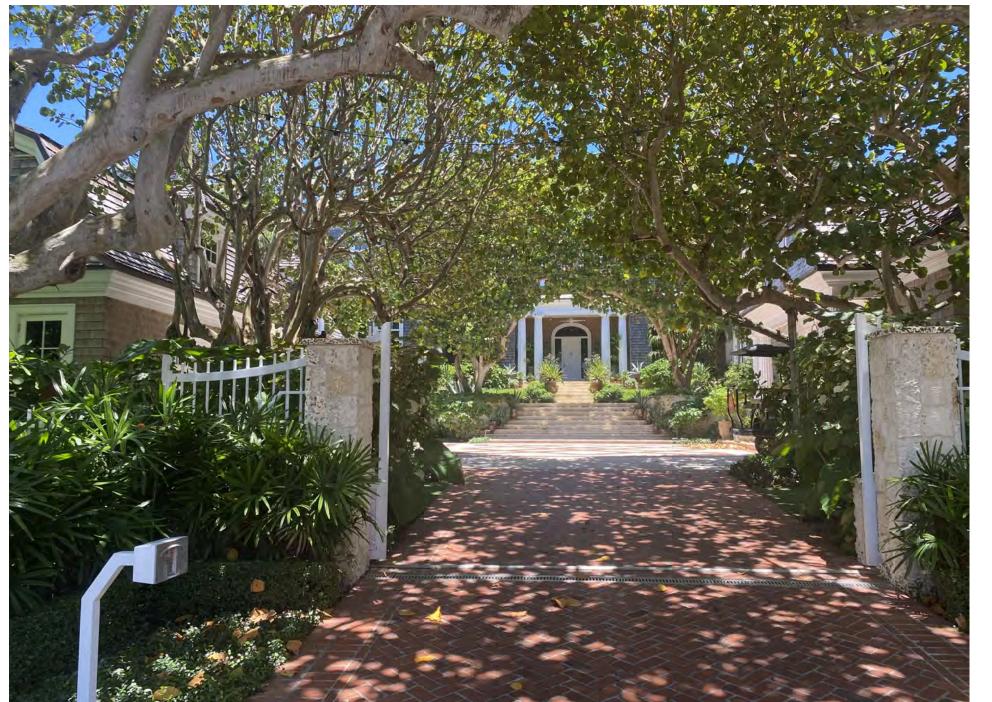

1237 N OCEAN WAY




1233 N OCEAN WAY



1195 N OCEAN WAY



110 MOCKINGBIRD TRAIL

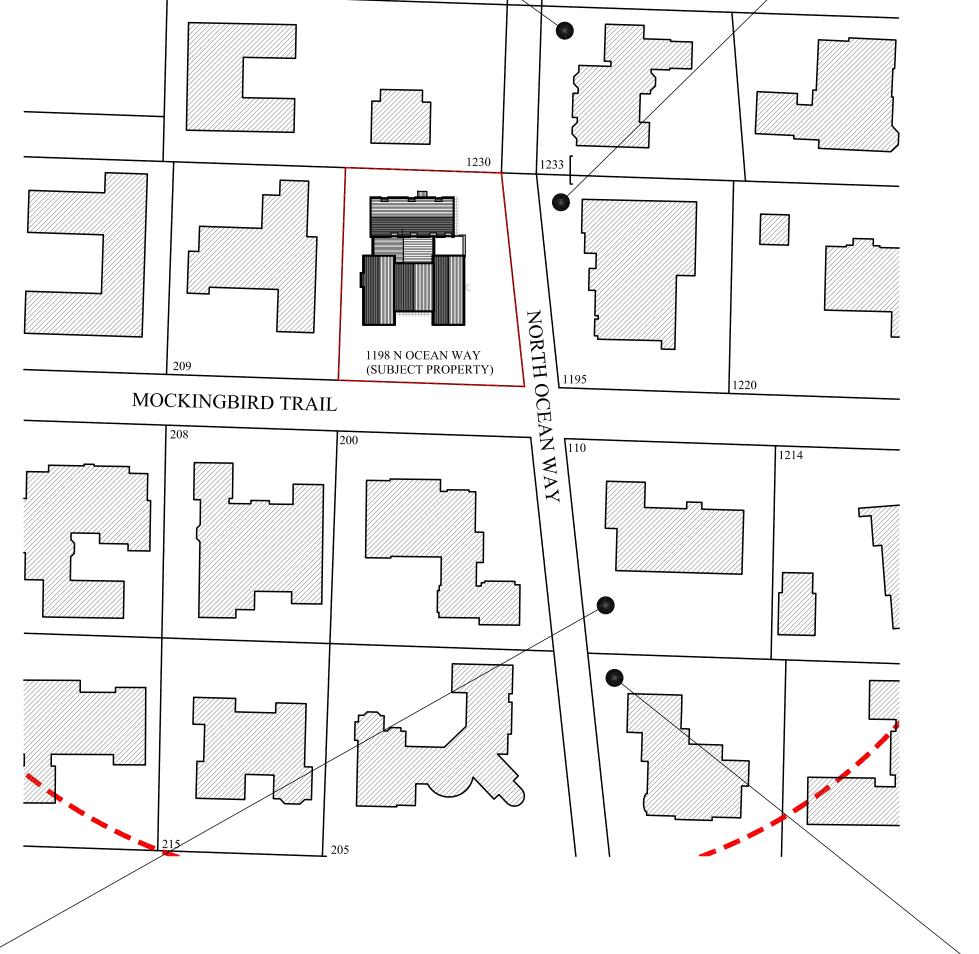

115 NIGHTINGALE TRAIL

NO. 001285

HAROLD J. SMITH REGISTERED ARCHITECT 8742


JONATHAN C. MOORE


PETER G. PAPADOPOULOS

DANIEL KAHAN

DESIGN DEVELOP. 2023-041-07 DROP-OFF SUBMITTAL 2023-05-08

NO: 22026 DWG. BY: PGP SHEET:

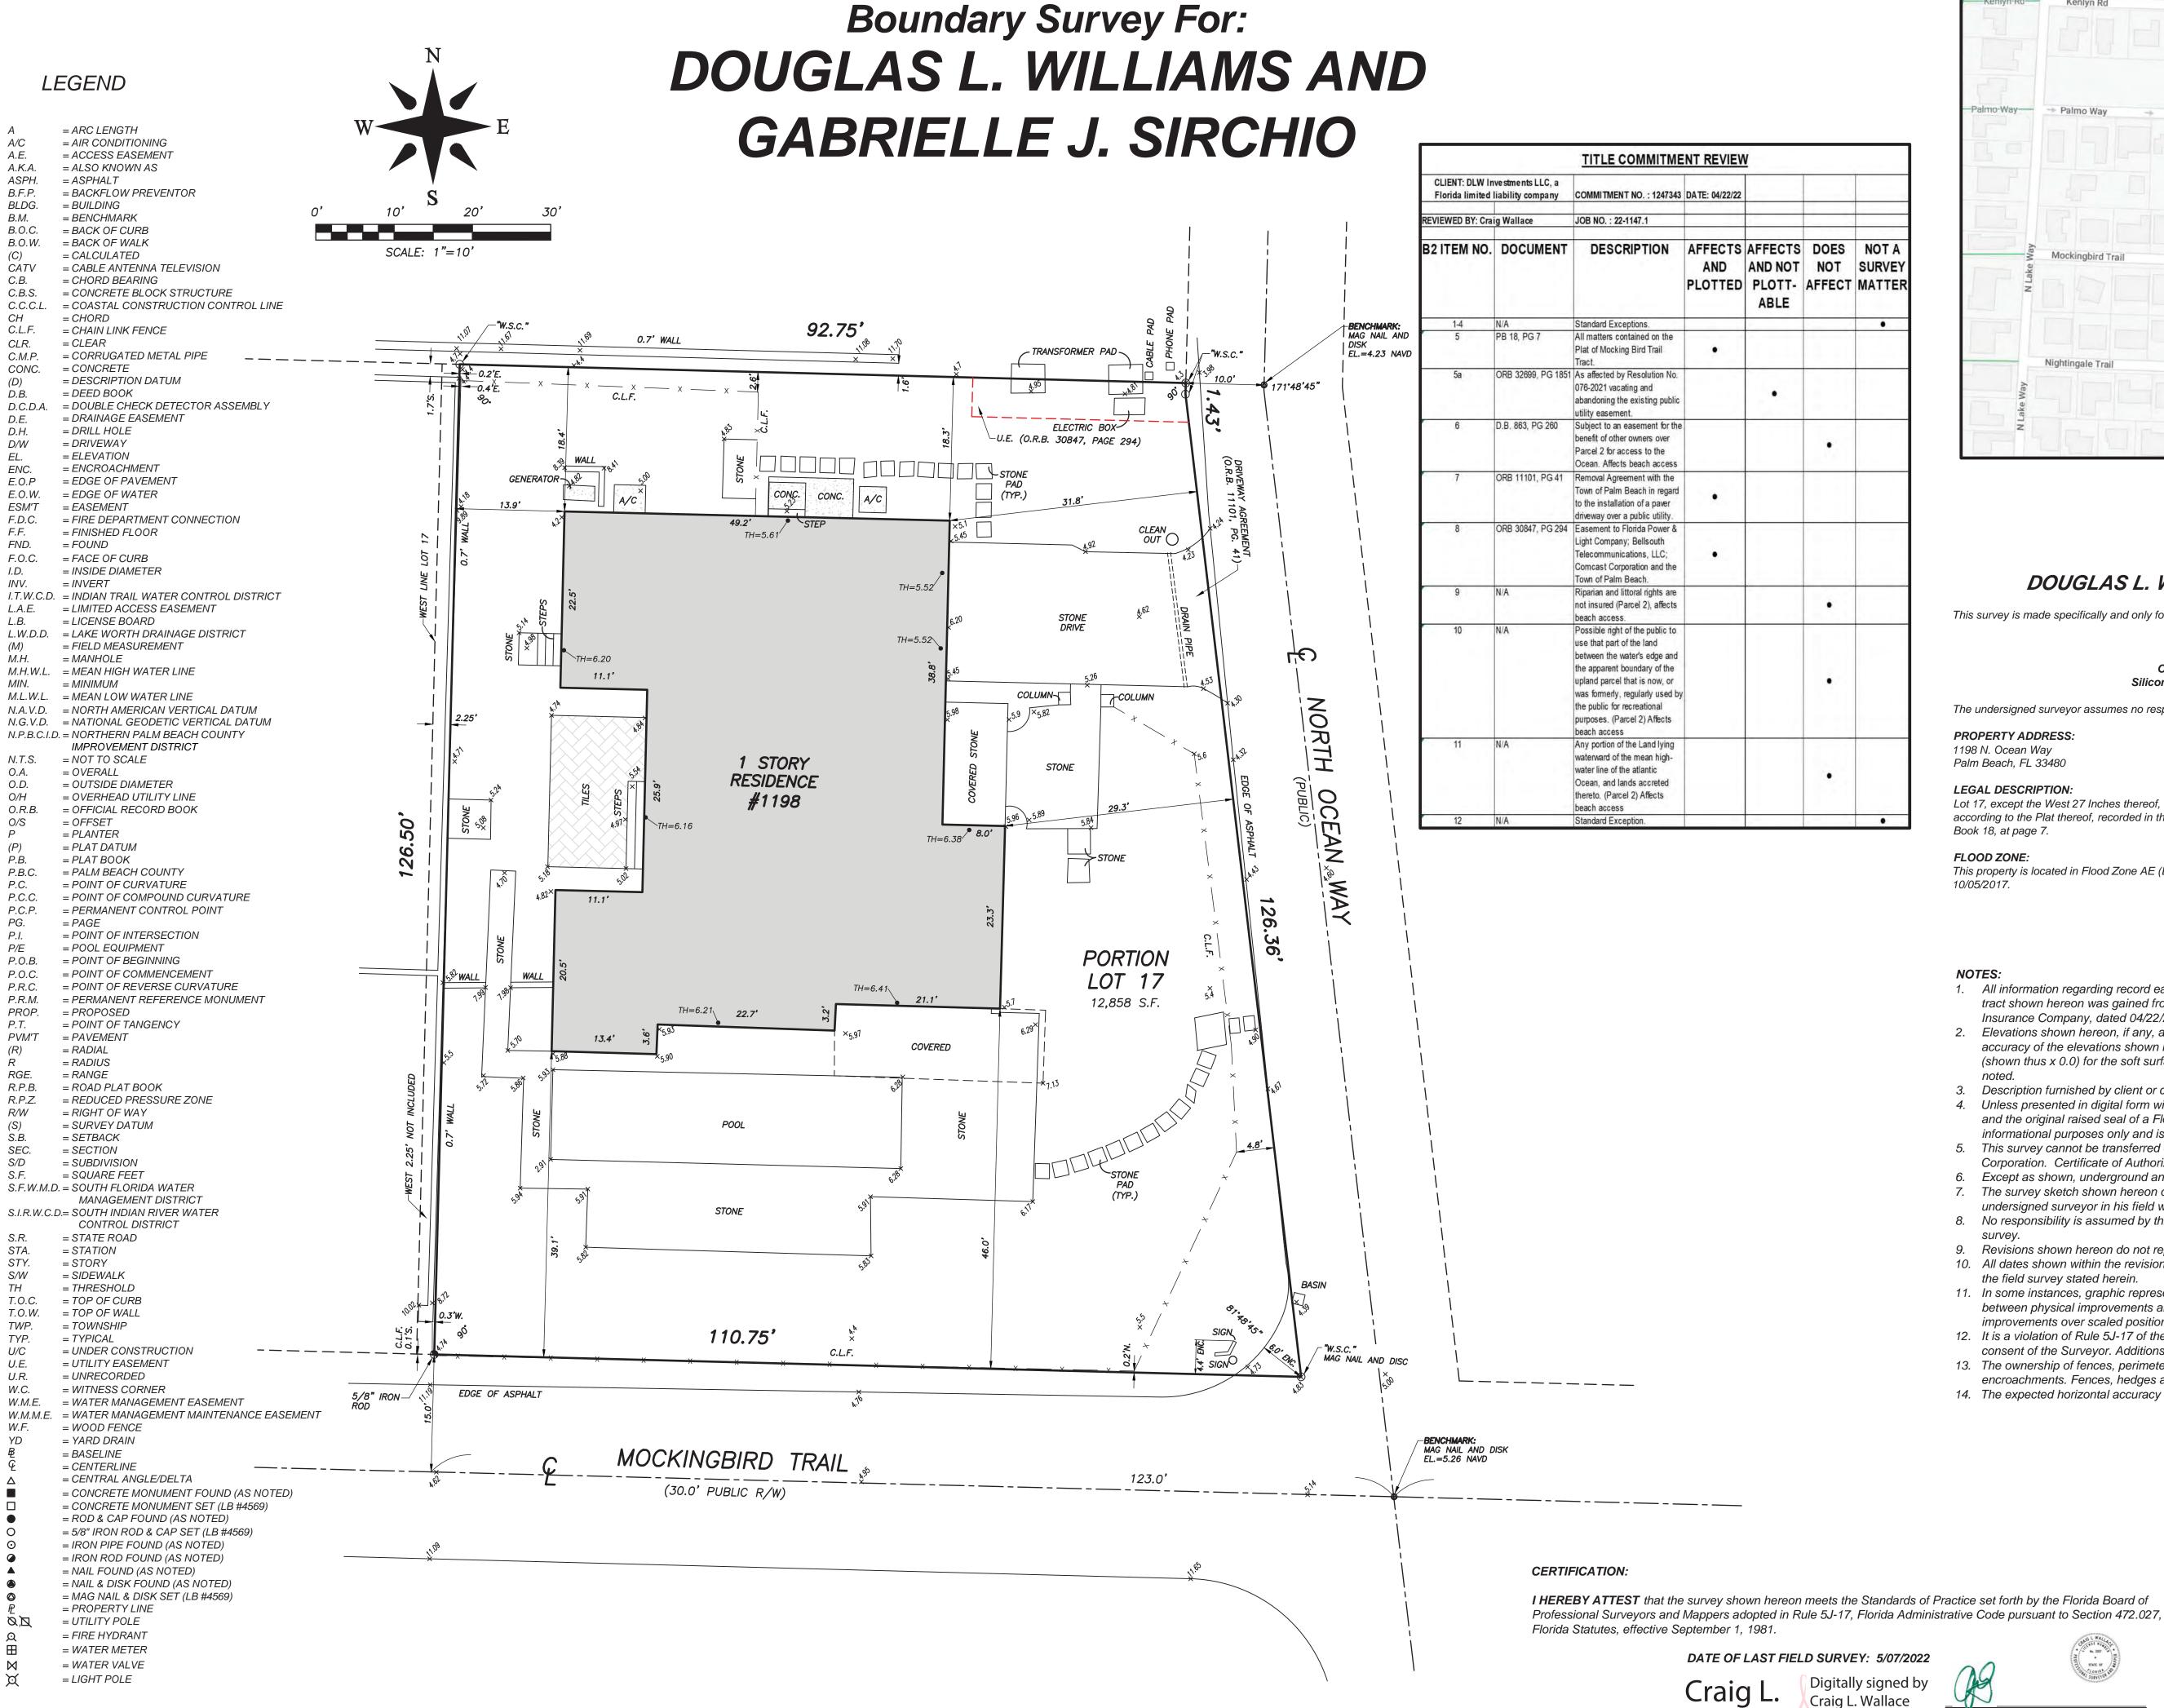

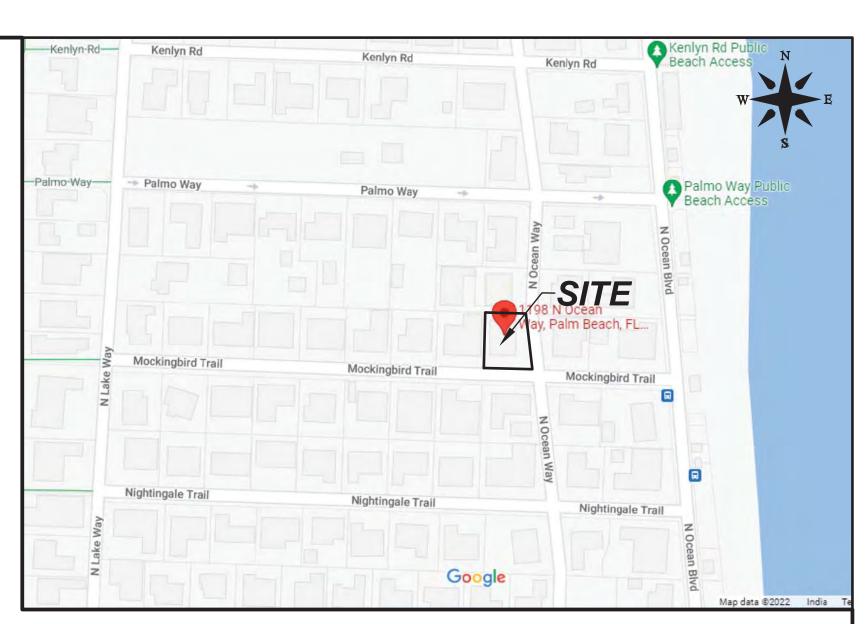

### **VICINITY SKETCH**

(NOT TO SCALE)

### **Boundary Survey For:** DOUGLAS L. WILLIAMS AND GABRIELLE J. SIRCHIO

This survey is made specifically and only for the following parties for the purpose of a permit on the surveyed property.

Douglas L. Williams and Gabrielle J. Sirchio Jones Foster P.A. Old Republic National Title Insurance Company Silicon Valley Bank, its successors and/or assigns ATIMA

The undersigned surveyor assumes no responsibility or liability for any other purpose or to any other party other than stated above.

### PROPERTY ADDRESS: 1198 N. Ocean Wav

Palm Beach, FL 33480

Lot 17, except the West 27 Inches thereof, MOCKINGBIRD TRAIL TRACT, a subdivision in the Town of Palm Beach, Florida, according to the Plat thereof, recorded in the Office of the Clerk of the Circuit Court in and for Palm Beach County, Florida.. in Plat Book 18, at page 7.

### FLOOD ZONE:

This property is located in Flood Zone AE (EL. 6), according to F.I.R.M. (Flood Insurance Rate Map) No. 12099C0393F, dated


- 1. All information regarding record easements, adjoiners, and other documents that might affect the quality of title to tract shown hereon was gained from commitment number 1247343, issued by Old Republic National Title Insurance Company, dated 04/22/22. This office has made no search of the Public Records.
- 2. Elevations shown hereon, if any, are in feet and decimal parts thereof and are based on NAVD-88. The expected accuracy of the elevations shown hereon is 0.03' for the hard surface elevations (shown thus x 0.00) and 0.1' (shown thus x 0.0) for the soft surface elevations. Elevations shown hereon are U.S. survey feet unless otherwise
- 3. Description furnished by client or client's agent.
- 4. Unless presented in digital form with electronic seal and electronic signature this survey must bear the signature and the original raised seal of a Florida licensed surveyor or mapper this drawing, sketch, plat or map is for informational purposes only and is not valid.
- 5. This survey cannot be transferred or assigned without the specific written permission of Wallace Surveying Corporation. Certificate of Authorization Number LB4569.
- 6. Except as shown, underground and overhead improvements are not located. Underground foundations not located. 7. The survey sketch shown hereon does not necessarily contain all of the information obtained or developed by the
- undersigned surveyor in his field work, office work or research. 8. No responsibility is assumed by this surveyor for the construction of improvements, from building ties shown on this
- 9. Revisions shown hereon do not represent a "survey update" unless otherwise noted.
- 10. All dates shown within the revisions block hereon are for interoffice filing use only and in no way affect the date of
- the field survey stated herein. 11. In some instances, graphic representations have been exaggerated to more clearly illustrate the relationships
- between physical improvements and/or lot lines. In all cases, dimensions shown shall control the location of the improvements over scaled positions. 12. It is a violation of Rule 5J-17 of the Florida Administrative Code to alter this survey without the express prior written
- consent of the Surveyor. Additions and/or deletions made to the face of this survey will make this survey invalid.
- 13. The ownership of fences, perimeter walls and/or hedges shown hereon are not known and thus are not listed as encroachments. Fences, hedges and/or perimeter walls are shown in their relative position to the boundary.

REVISIONS:

14. The expected horizontal accuracy of the information shown hereon is +/- 0.10'.

Boundary Survey For:

DOUGLAS L. WILLIAMS AND GABRIELLE J. SIRCHIO

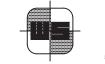


5553 VILLAGE BOULEVARD, WEST PALM BEACH, FLORIDA 33407 \* (561) 640-4551

FIELD: J.D. JOB No.: 22-1147 F.B. PB332 PG. 20-2 OFFICE: D.R. DATE: 05/07/2022 DWG. No.: 22-1147-1 SHEET: 1 OF 1 REF.: 22-1147.dwg C'K'D.: C.W.

Florida Certificate No. 3357

Craig L. Wallace Professional Surveyor and Mapper

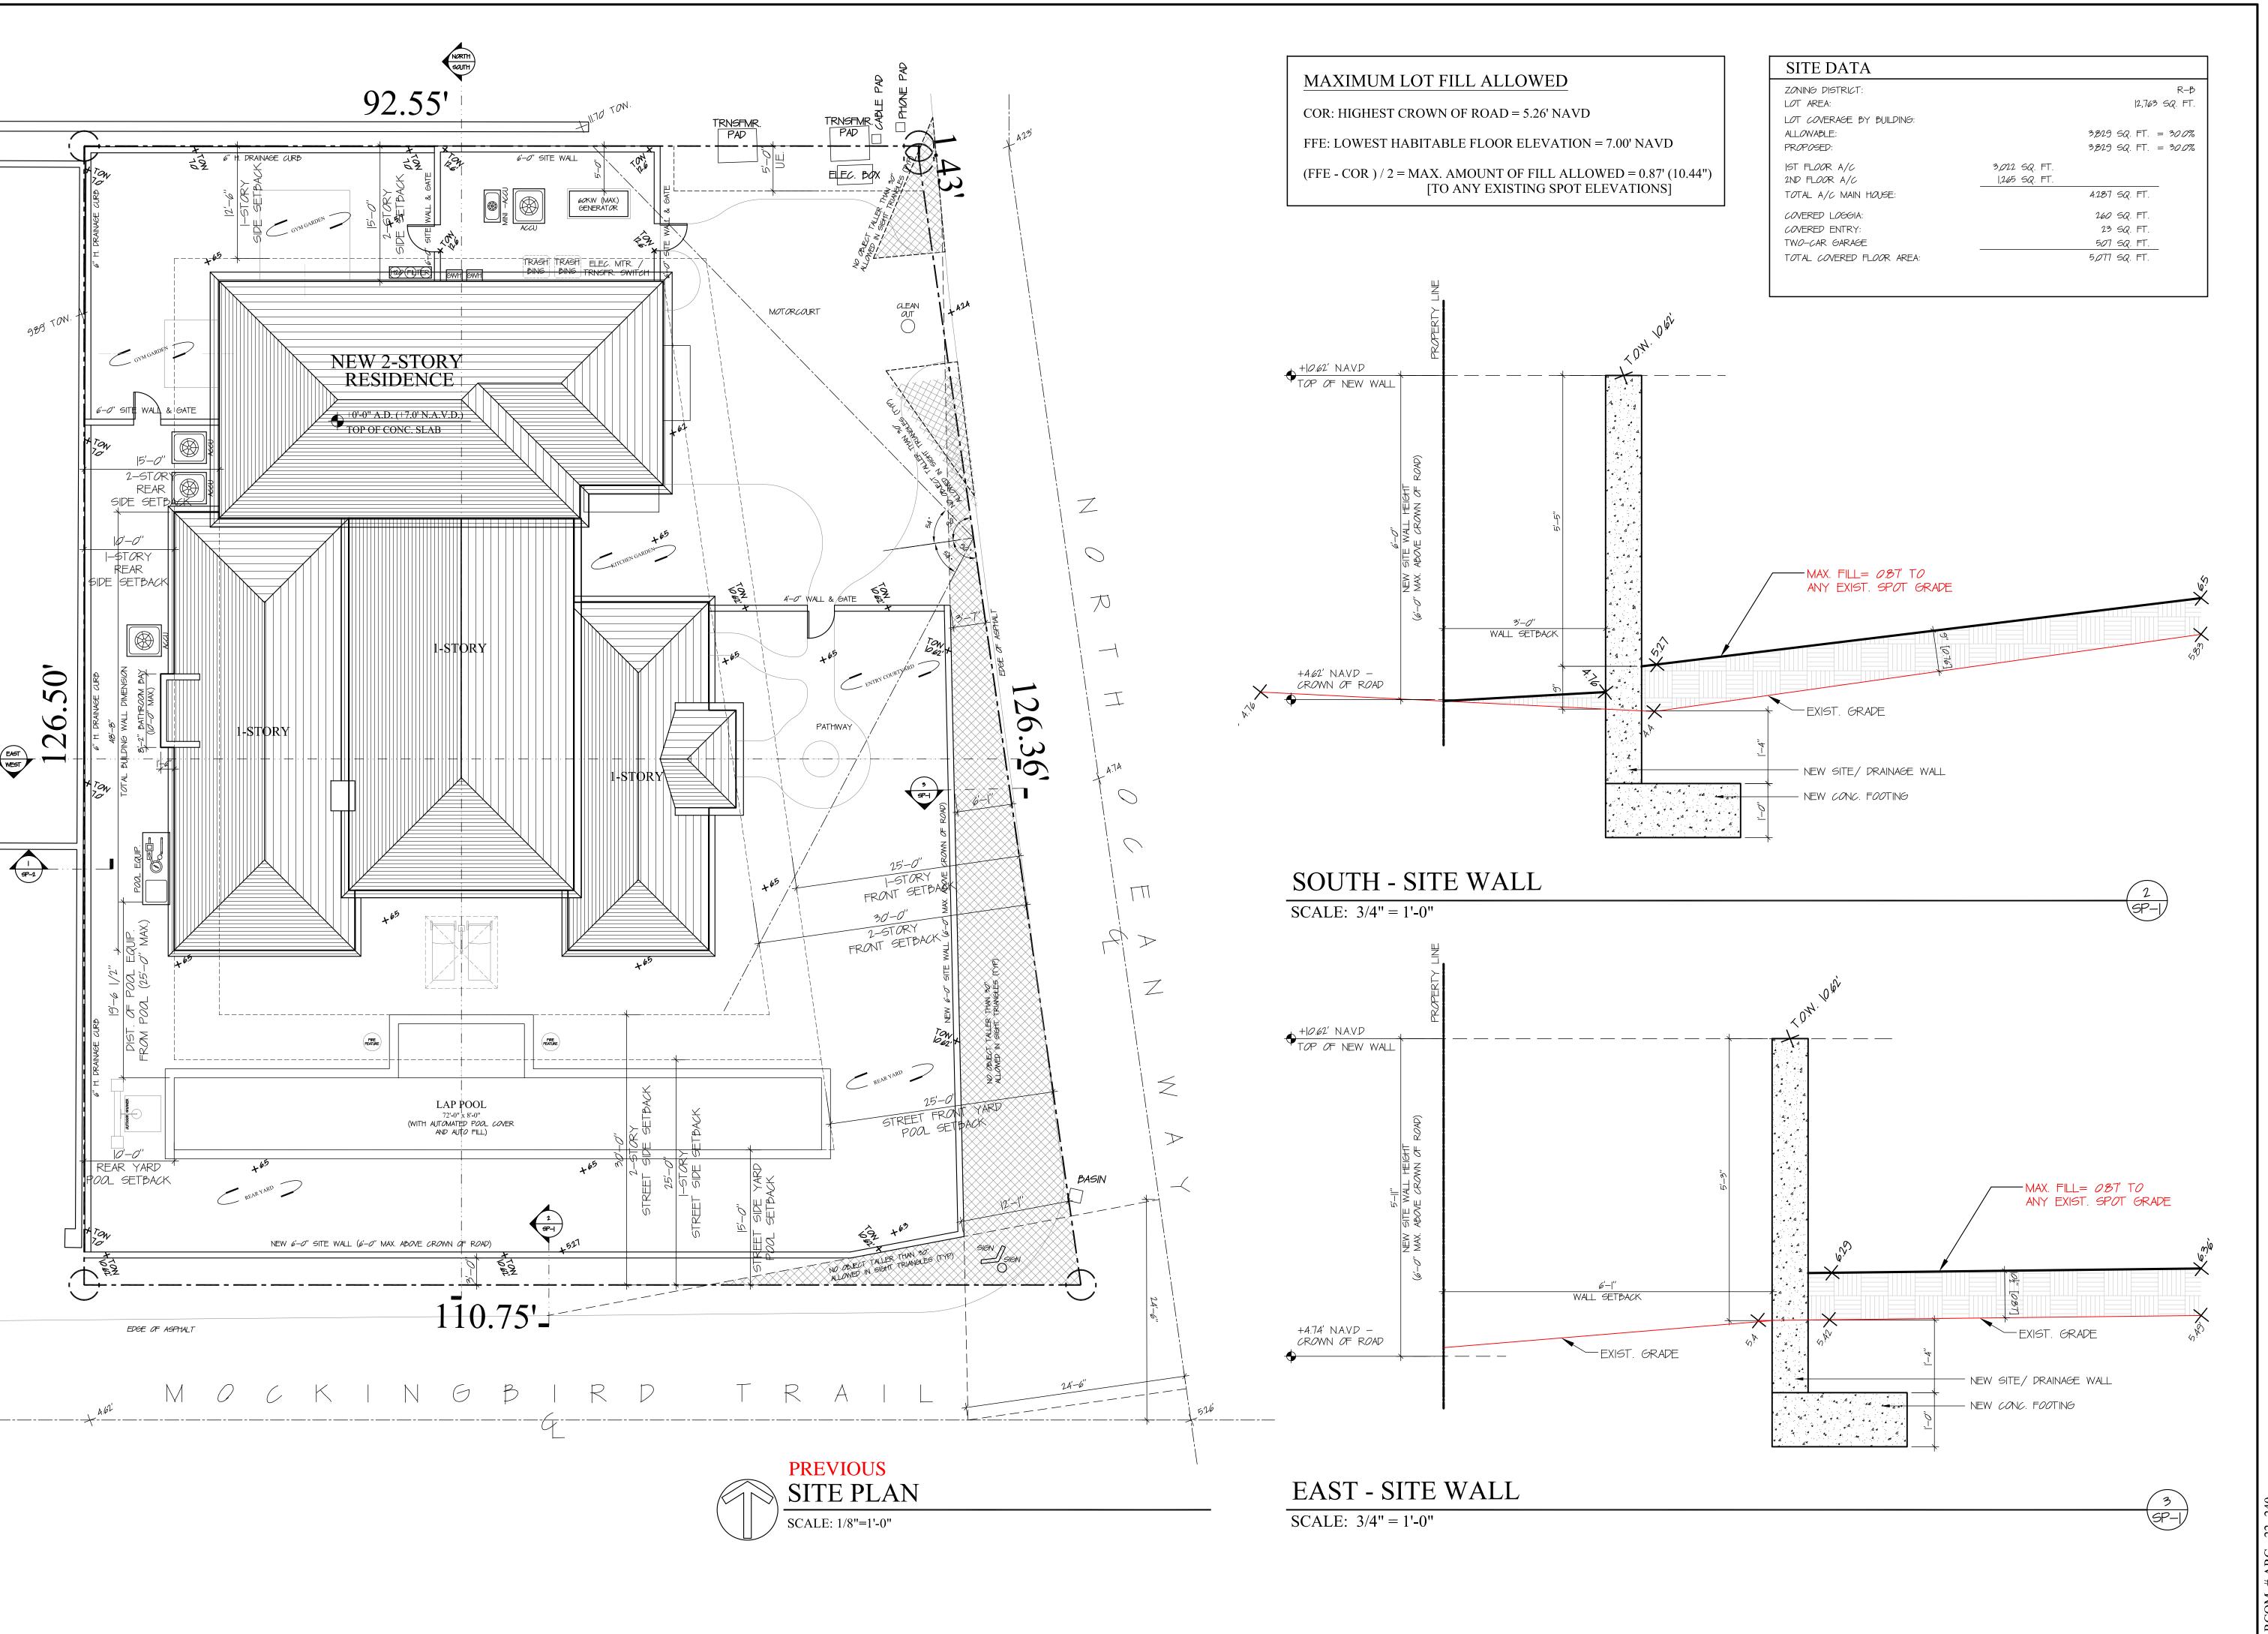



[I] 

FLORIDA AAC NO. 001285

HAROLD J. SMITH REGISTERED ARCHITECT 8742

JONATHAN C. MOORE REGISTERED ARCHITECT 13541 PETER G. PAPADOPOULOS


REGISTERED ARCHITECT 92952 DANIEL KAHAN

REGISTERED ARCHITECT 94757

SCHEM. DESIGN

PRE-APP SUBMITTAL 2022-09-1 FIRST SUBMITTAL 2022-11-07 SECOND SUBMITTAL 2022-11-28 DROP-OFF SUBMITTAL 2022-12-09

NO: 22026 DWG. BY: PGP/HJS SHEET:

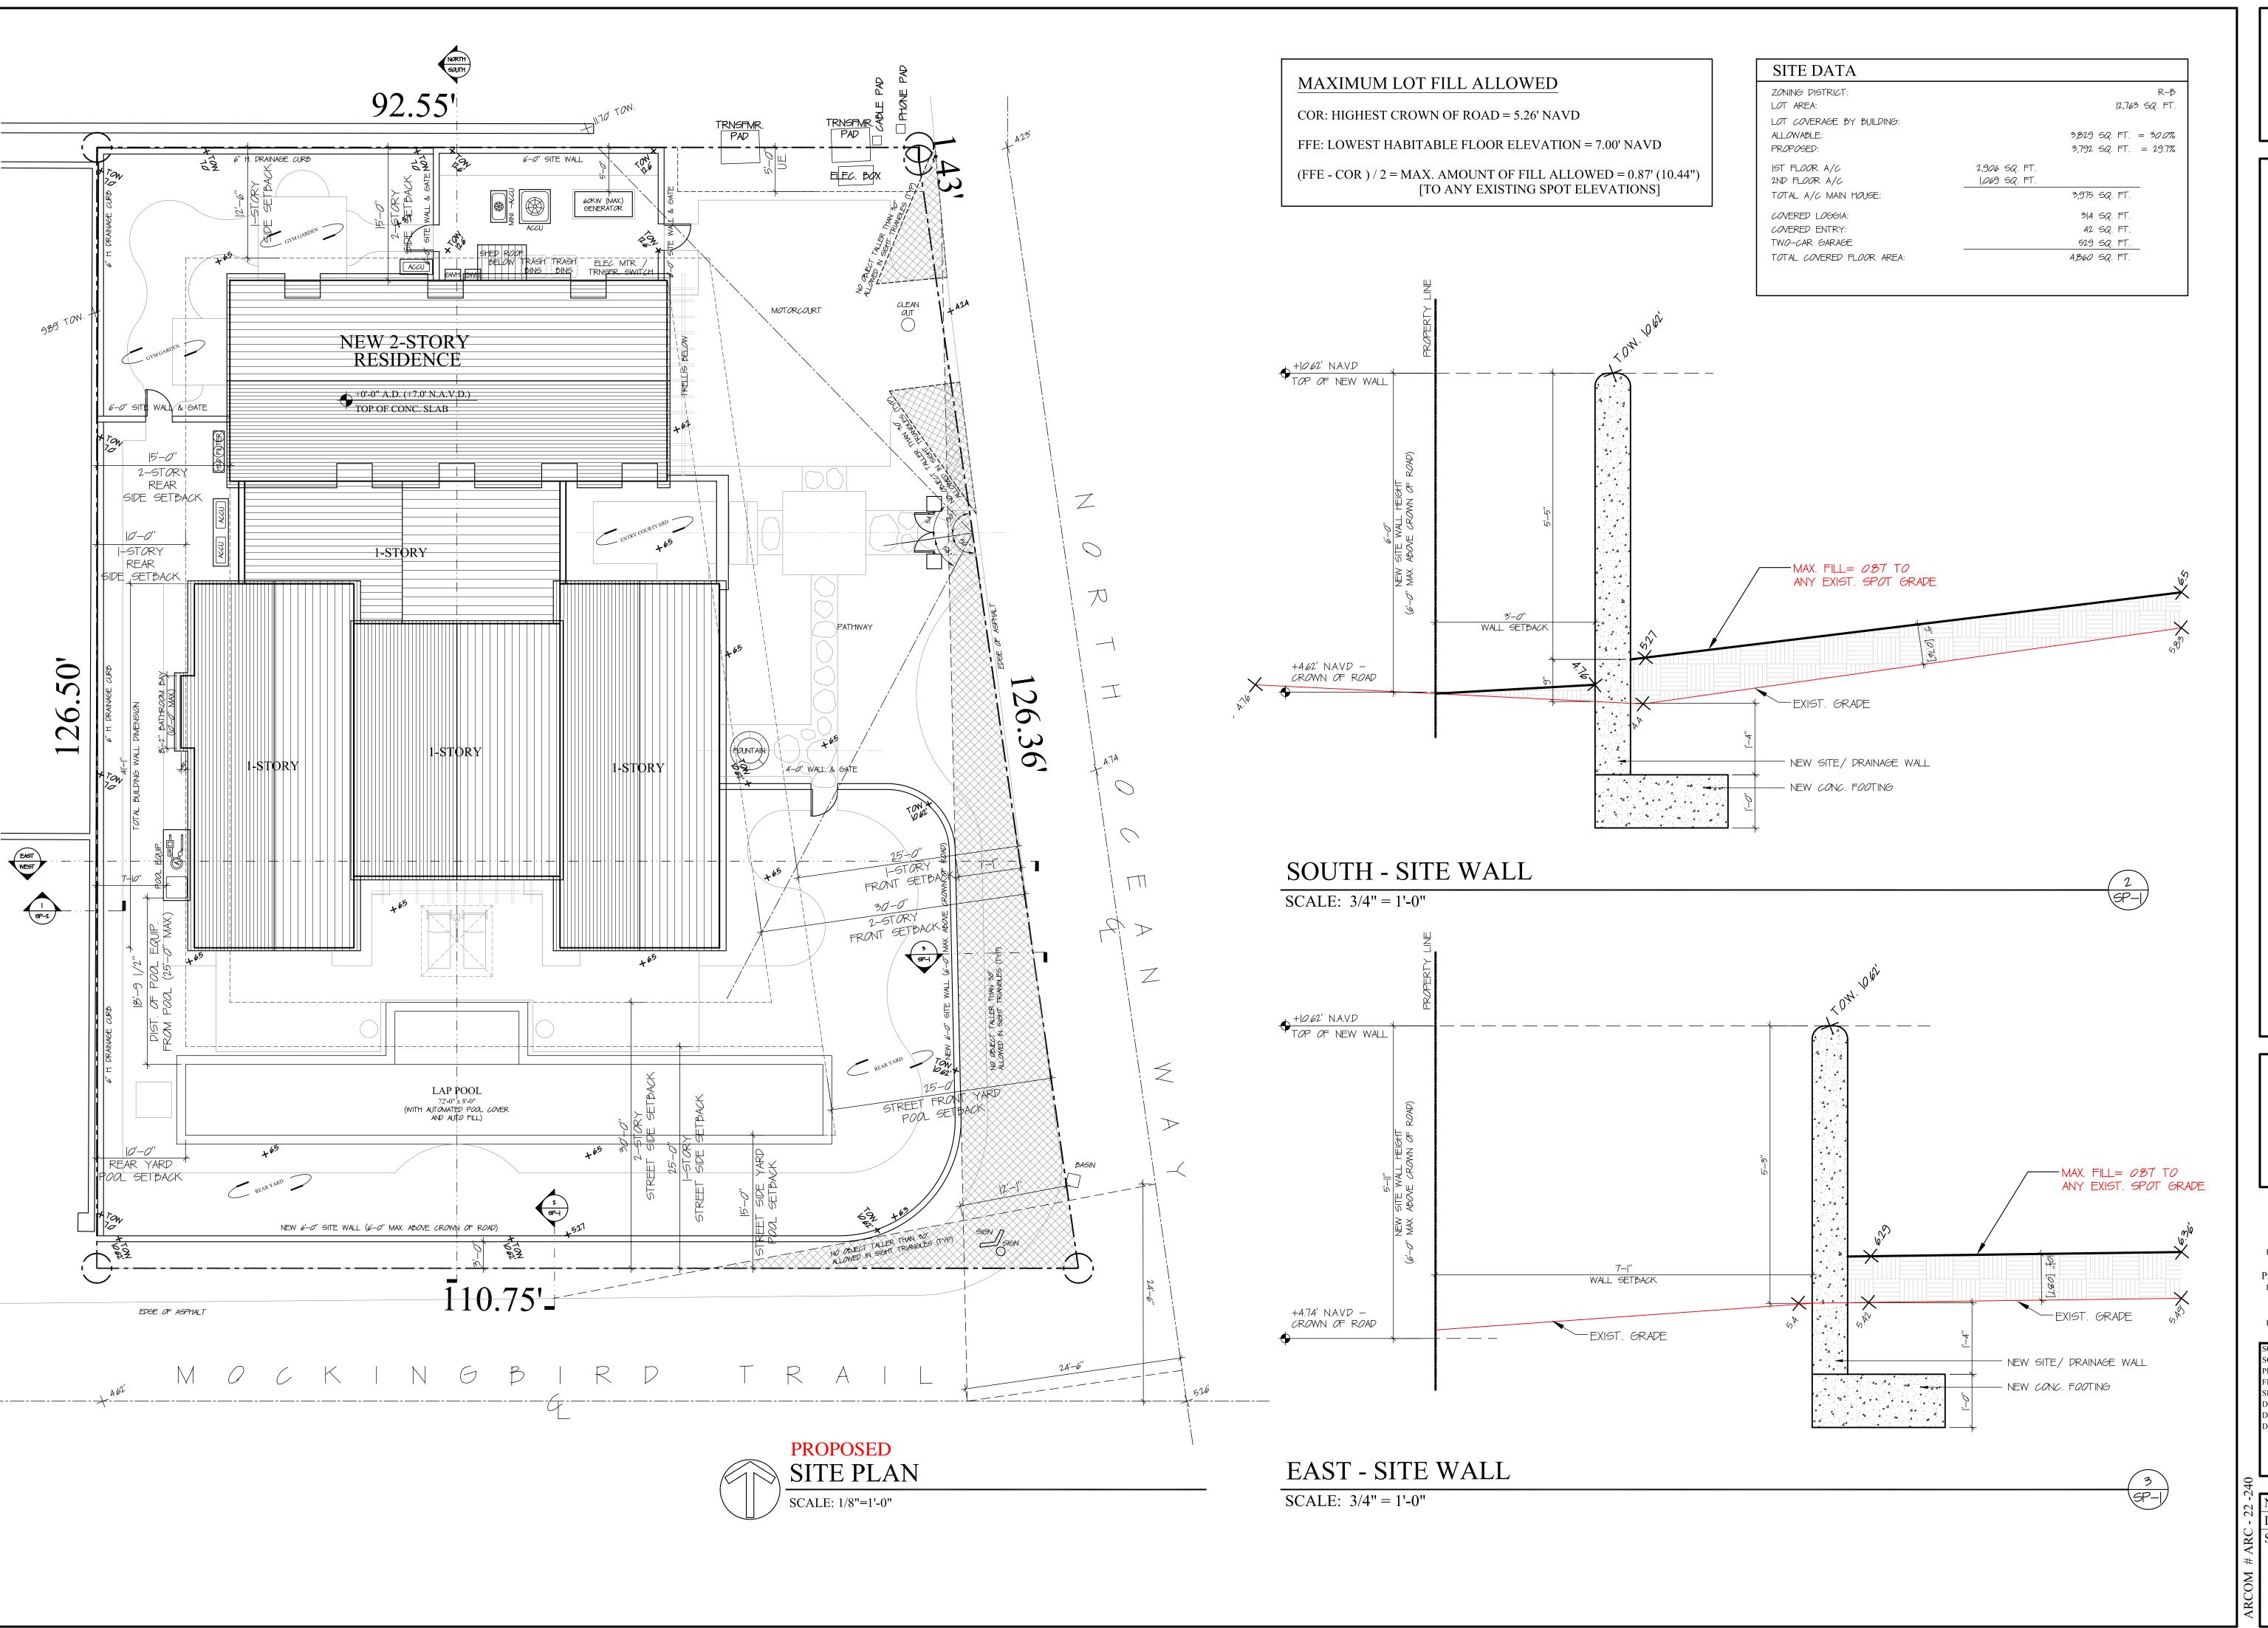

SM

WILLIAMS AND SIRCHIO
1198 NORTH OCEAN WAY, PALM BEACH

[ITH AND MOORE ARCHITECTS, IN

FLORIDA AAC NO. 001285

HAROLD J. SMITH REGISTERED ARCHITECT 8742

JONATHAN C. MOORE REGISTERED ARCHITECT 13541

PETER G. PAPADOPOULOS REGISTERED ARCHITECT 92952

DANIEL KAHAN
REGISTERED ARCHITECT 94757

SCHEM. DESIGN 2022-08-08
SCHEM. DESIGN 2022-08-26

 SCHEM. DESIGN
 2022-08-08

 SCHEM. DESIGN
 2022-08-26

 PRE-APP SUBMITTAL
 2022-09-19

 FIRST SUBMITTAL
 2022-11-07


 SECOND SUBMITTAL
 2022-11-28

 DROP-OFF SUBMITTAL
 2022-12-09

 DESIGN DEVELOP.
 2023-041-07

 DROP-OFF SUBMITTAL
 2023-05-08

NO: 22026 DWG. BY: PGP SHEET:

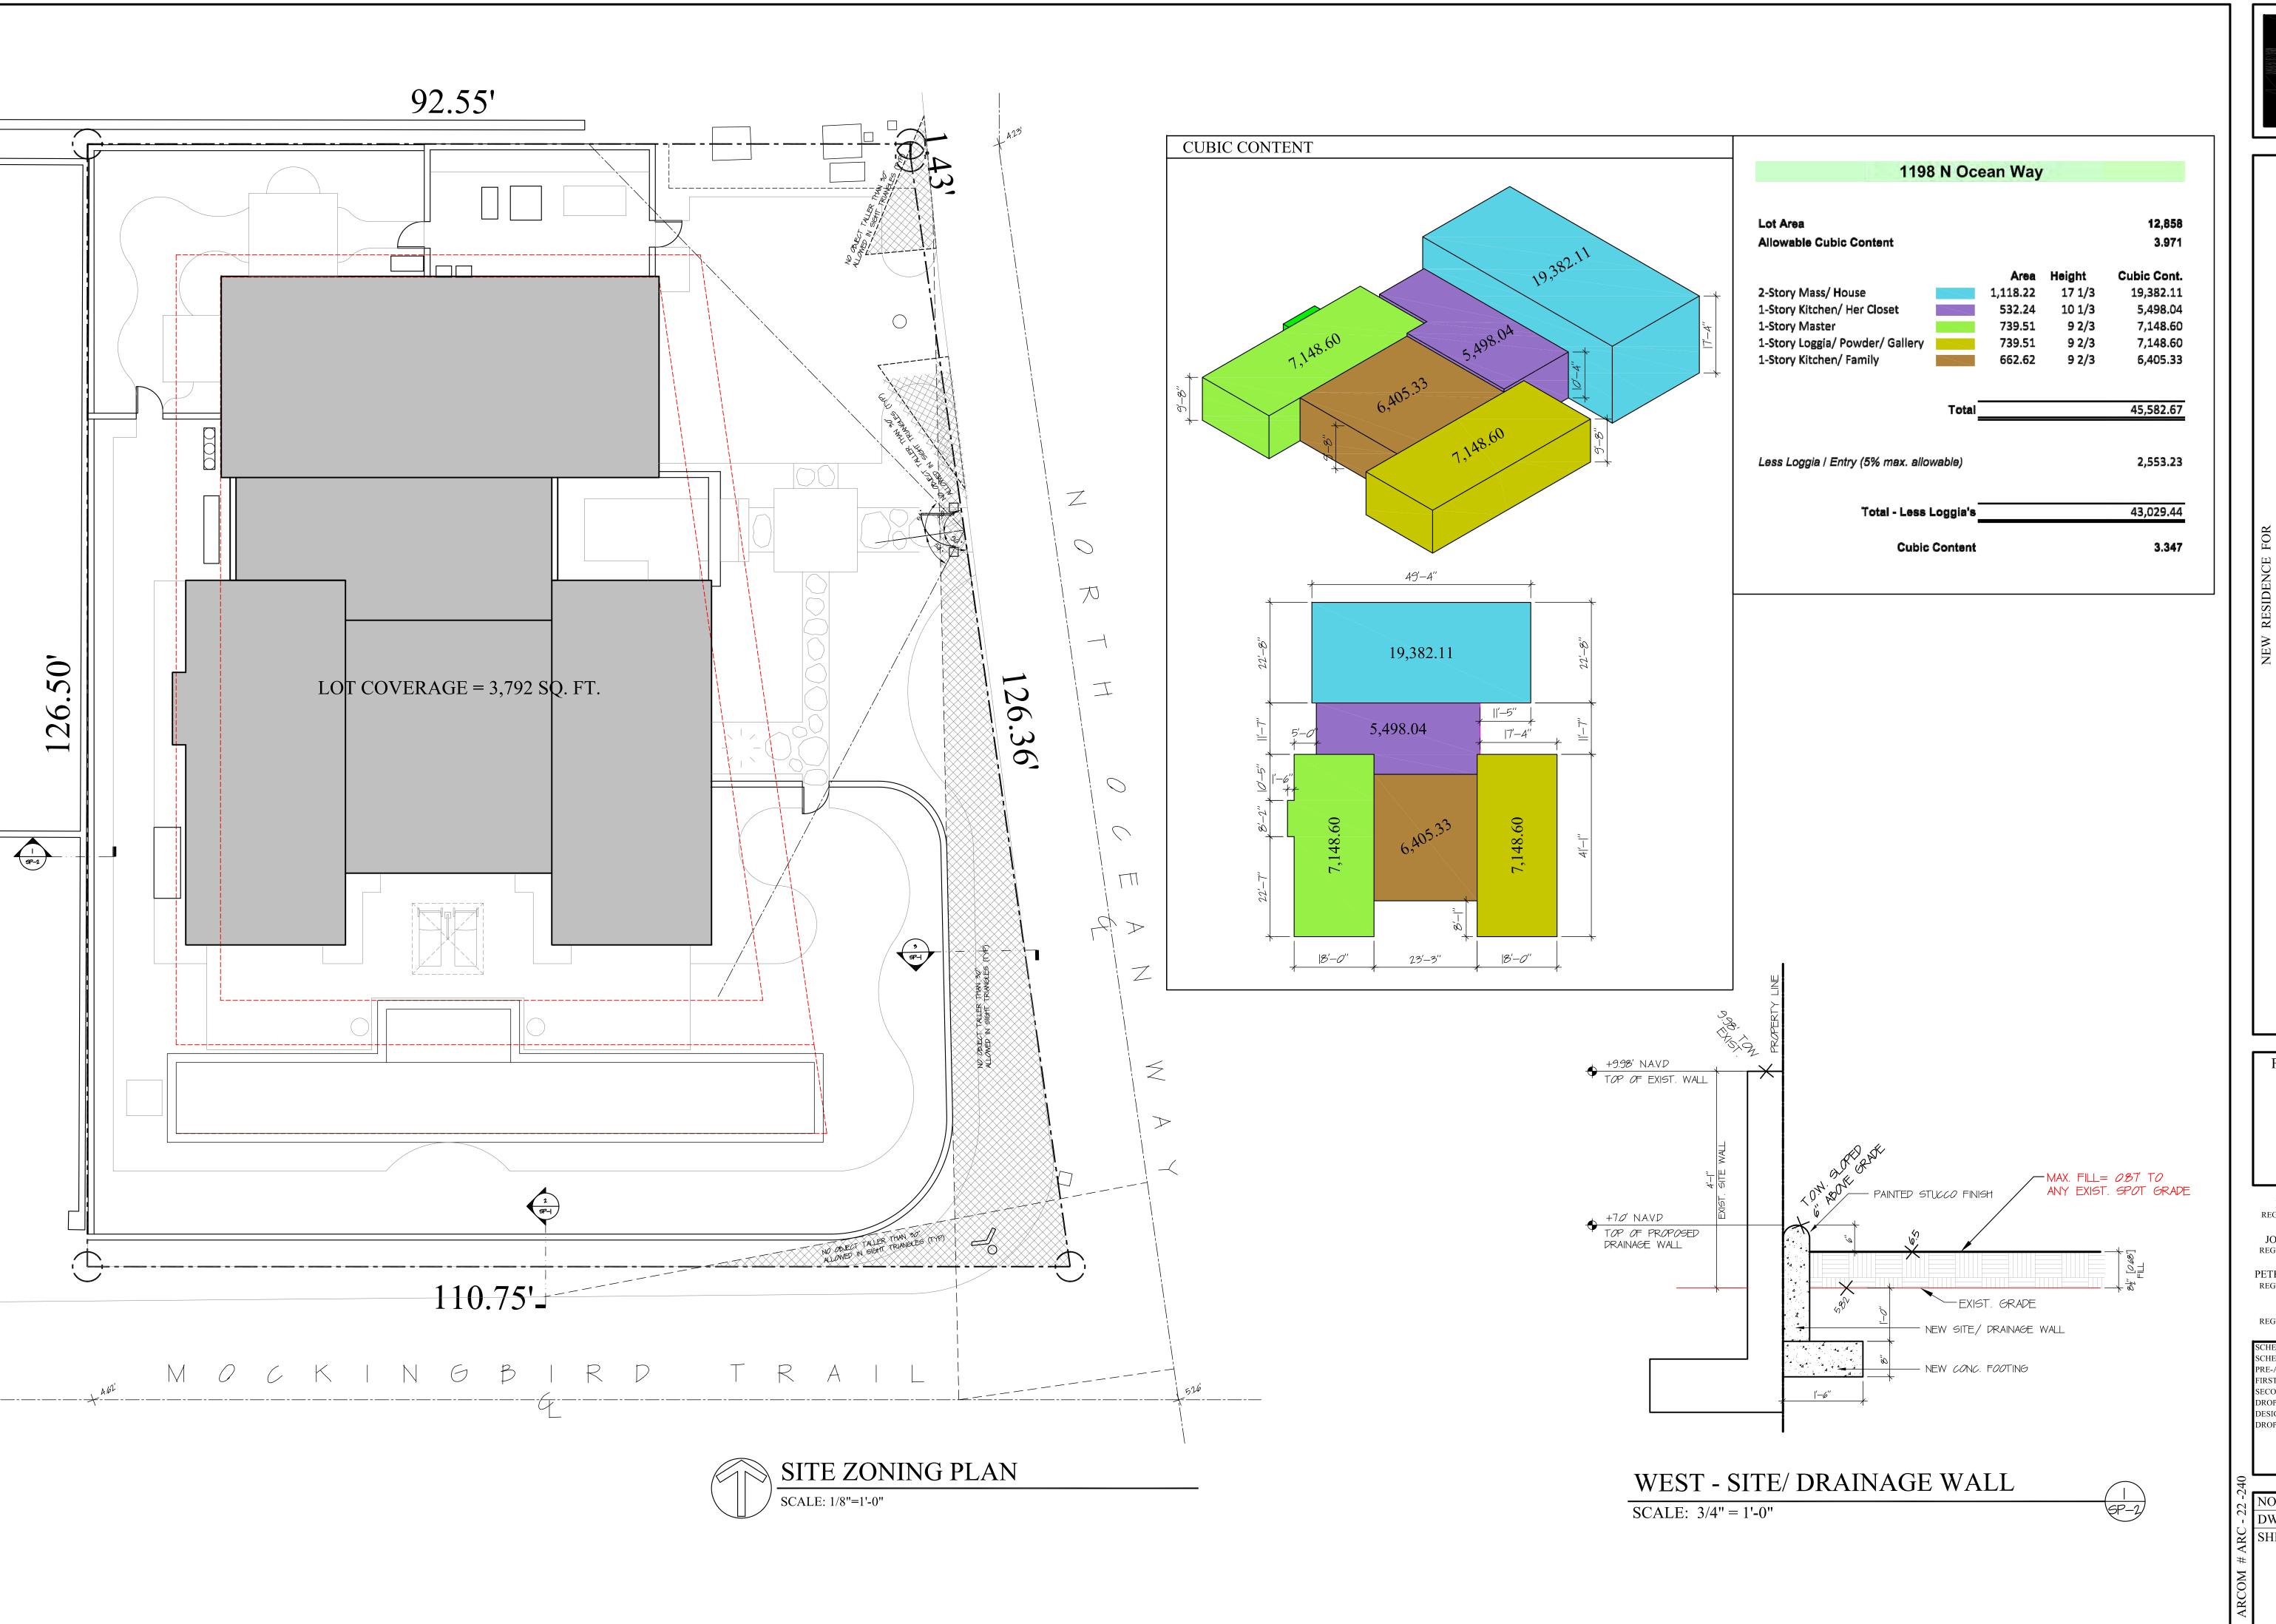



WILLIAMS AND SIRCHIO
1198 NORTH OCEAN WAY, PALM BEACH
AND MOORE ARCHITECTS, IN

FLORIDA AAC NO. 001285

HAROLD J. SMITH REGISTERED ARCHITECT 8742

JONATHAN C. MOORE REGISTERED ARCHITECT 13541

PETER G. PAPADOPOULOS REGISTERED ARCHITECT 92952

DANIEL KAHAN REGISTERED ARCHITECT 94757

 SCHEM. DESIGN
 2022-08-08

 SCHEM. DESIGN
 2022-08-26

 PRE-APP SUBMITTAL
 2022-09-19

 FIRST SUBMITTAL
 2022-11-07

 SECOND SUBMITTAL
 2022-11-28

 DROP-OFF SUBMITTAL
 2022-12-09

 DESIGN DEVELOP.
 2023-041-07

 DROP-OFF SUBMITTAL
 2023-05-08

NO: 22026 DWG. BY: PGP SHEET:



### Town of Palm Beach

Planning Zoning and Building 360 S County Rd Palm Beach, FL 33480 www.townofpalmbeach.com

Line #	Zoning Legend						
1	Property Address: 1198 N. Ocean Way						
2	Zoning District:	R-B					
3	Structure Type:	New 2-story Residence					
4		Required/Allowed	Existing	Proposed			
5	Lot Size (sq ft)	10,000 sf	12,763 sf	12,763 sf			
6	Lot Depth	100.0'	101.58'	101.58'			
7	Lot Width	100.0'	126.82'	126.82'			
8	Lot Coverage (Sq Ft and %)	3,829 sf (30%)	3,484 sf (27.3%)	3,829 sf (30%) 3,792 sf (29.7%)			
9	Enclosed Square Footage (1st & 2nd Fl., Basement, Accs. Structure, etc)	-	3,120 sf	4,287 sf 3,975 sf			
10	Cubic Content Ratio (CCR) (R-B ONLY)		2.258	3.821 3.347			
11	*Front Yard Setback (Ft.)	25' / 30'	27.75' 29.1	<del>28.83'</del> / 30'			
12	* Side Yard Setback (1st Story) (Ft.)	25' S / 12.5' N	36.83' S / 18.3' N	<del>37.2 S</del> → 36.2 S			
13	* Side Yard Setback (2nd Story) (Ft.)	30' S / 15' N	- 88.1 S <b>∢</b> -	<del>43.83' S</del> / 15' N			
14	*Rear Yard Setback (Ft.)	10' / 15' W	13.83' W 11' <del></del>	<del>-10'</del> / 15' W			
15	Angle of Vision (Deg.)	108 deg.	99 deg.	97 deg. > 98 deg.			
16	Building Height (Ft.)	22'	8'-4"	<del>19'-6"</del> 17'-4"			
17	Overall Building Height (Ft.)	30'	17'-0"	<del>24'-5"</del> 27'-6"			
18	Crown of Road (COR) (NAVD)	5.26'	5.26'	5.26'			
19	Max. Amount of Fill Added to Site (Ft.)	0.87'	N/A	.87' (10.44")			
20	Finished Floor Elev. (FFE)(NAVD)	7'	6.38'	7.125'			
21	Zero Datum for point of meas. (NAVD)	7'	6.38'	7'			
22	FEMA Flood Zone Designation	AE (EL 6)	AE (EL 6)	AE (EL 6)			
23	Base Flood Elevation (BFE)(NAVD)	7'	7'	7'			
24	Landscape Open Space (LOS) (Sq Ft and %)	5,786.26 sf (45%)	N/A	5,838 sf (45.4%) 5,812 sf (45.2%)			
25	Perimeter LOS (Sq Ft and %)	2,087.02 sf (50%)	N/A	3,332.73 sf (79.84%) 3,333 sf (79.8%)			
26	Front Yard LOS (Sq Ft and %)	1,259.8 sf (40%)	N/A	2,100.9 sf (65.77%)			
27	**Native Plant Species %	Please refer to separate landscape legend.					

<sup>\*</sup> Indicate each yard area with cardinal direction (N,S,E,W)

If value is not applicable, enter N/A

\*\* Provide Native plant species calculation per category as requited by Ord. 24-2021 on separate table

If value is not changing, enter N/C

REV BF 20220616

# NEW RESIDENCE FOR WILLIAMS AND SIRCHIO 1198 NORTH OCEAN WAY, PALM BEACH

FLORIDA AAC

NO. 001285

HAROLD J. SMITH REGISTERED ARCHITECT 8742

SCHEM. DESIGN 2022-08-08
SCHEM. DESIGN 2022-08-26
PRE-APP SUBMITTAL 2022-09-19
FIRST SUBMITTAL 2022-11-07
SECOND SUBMITTAL 2022-11-28
DROP-OFF SUBMITTAL 2022-12-09
DESIGN DEVELOP. 2023-041-07
DROP-OFF SUBMITTAL 2023-05-08

JONATHAN C. MOORE

REGISTERED ARCHITECT 13541


PETER G. PAPADOPOULOS

REGISTERED ARCHITECT 92952


DANIEL KAHAN

REGISTERED ARCHITECT 94757

NO: 22026 DWG. BY: PGP SHEET:

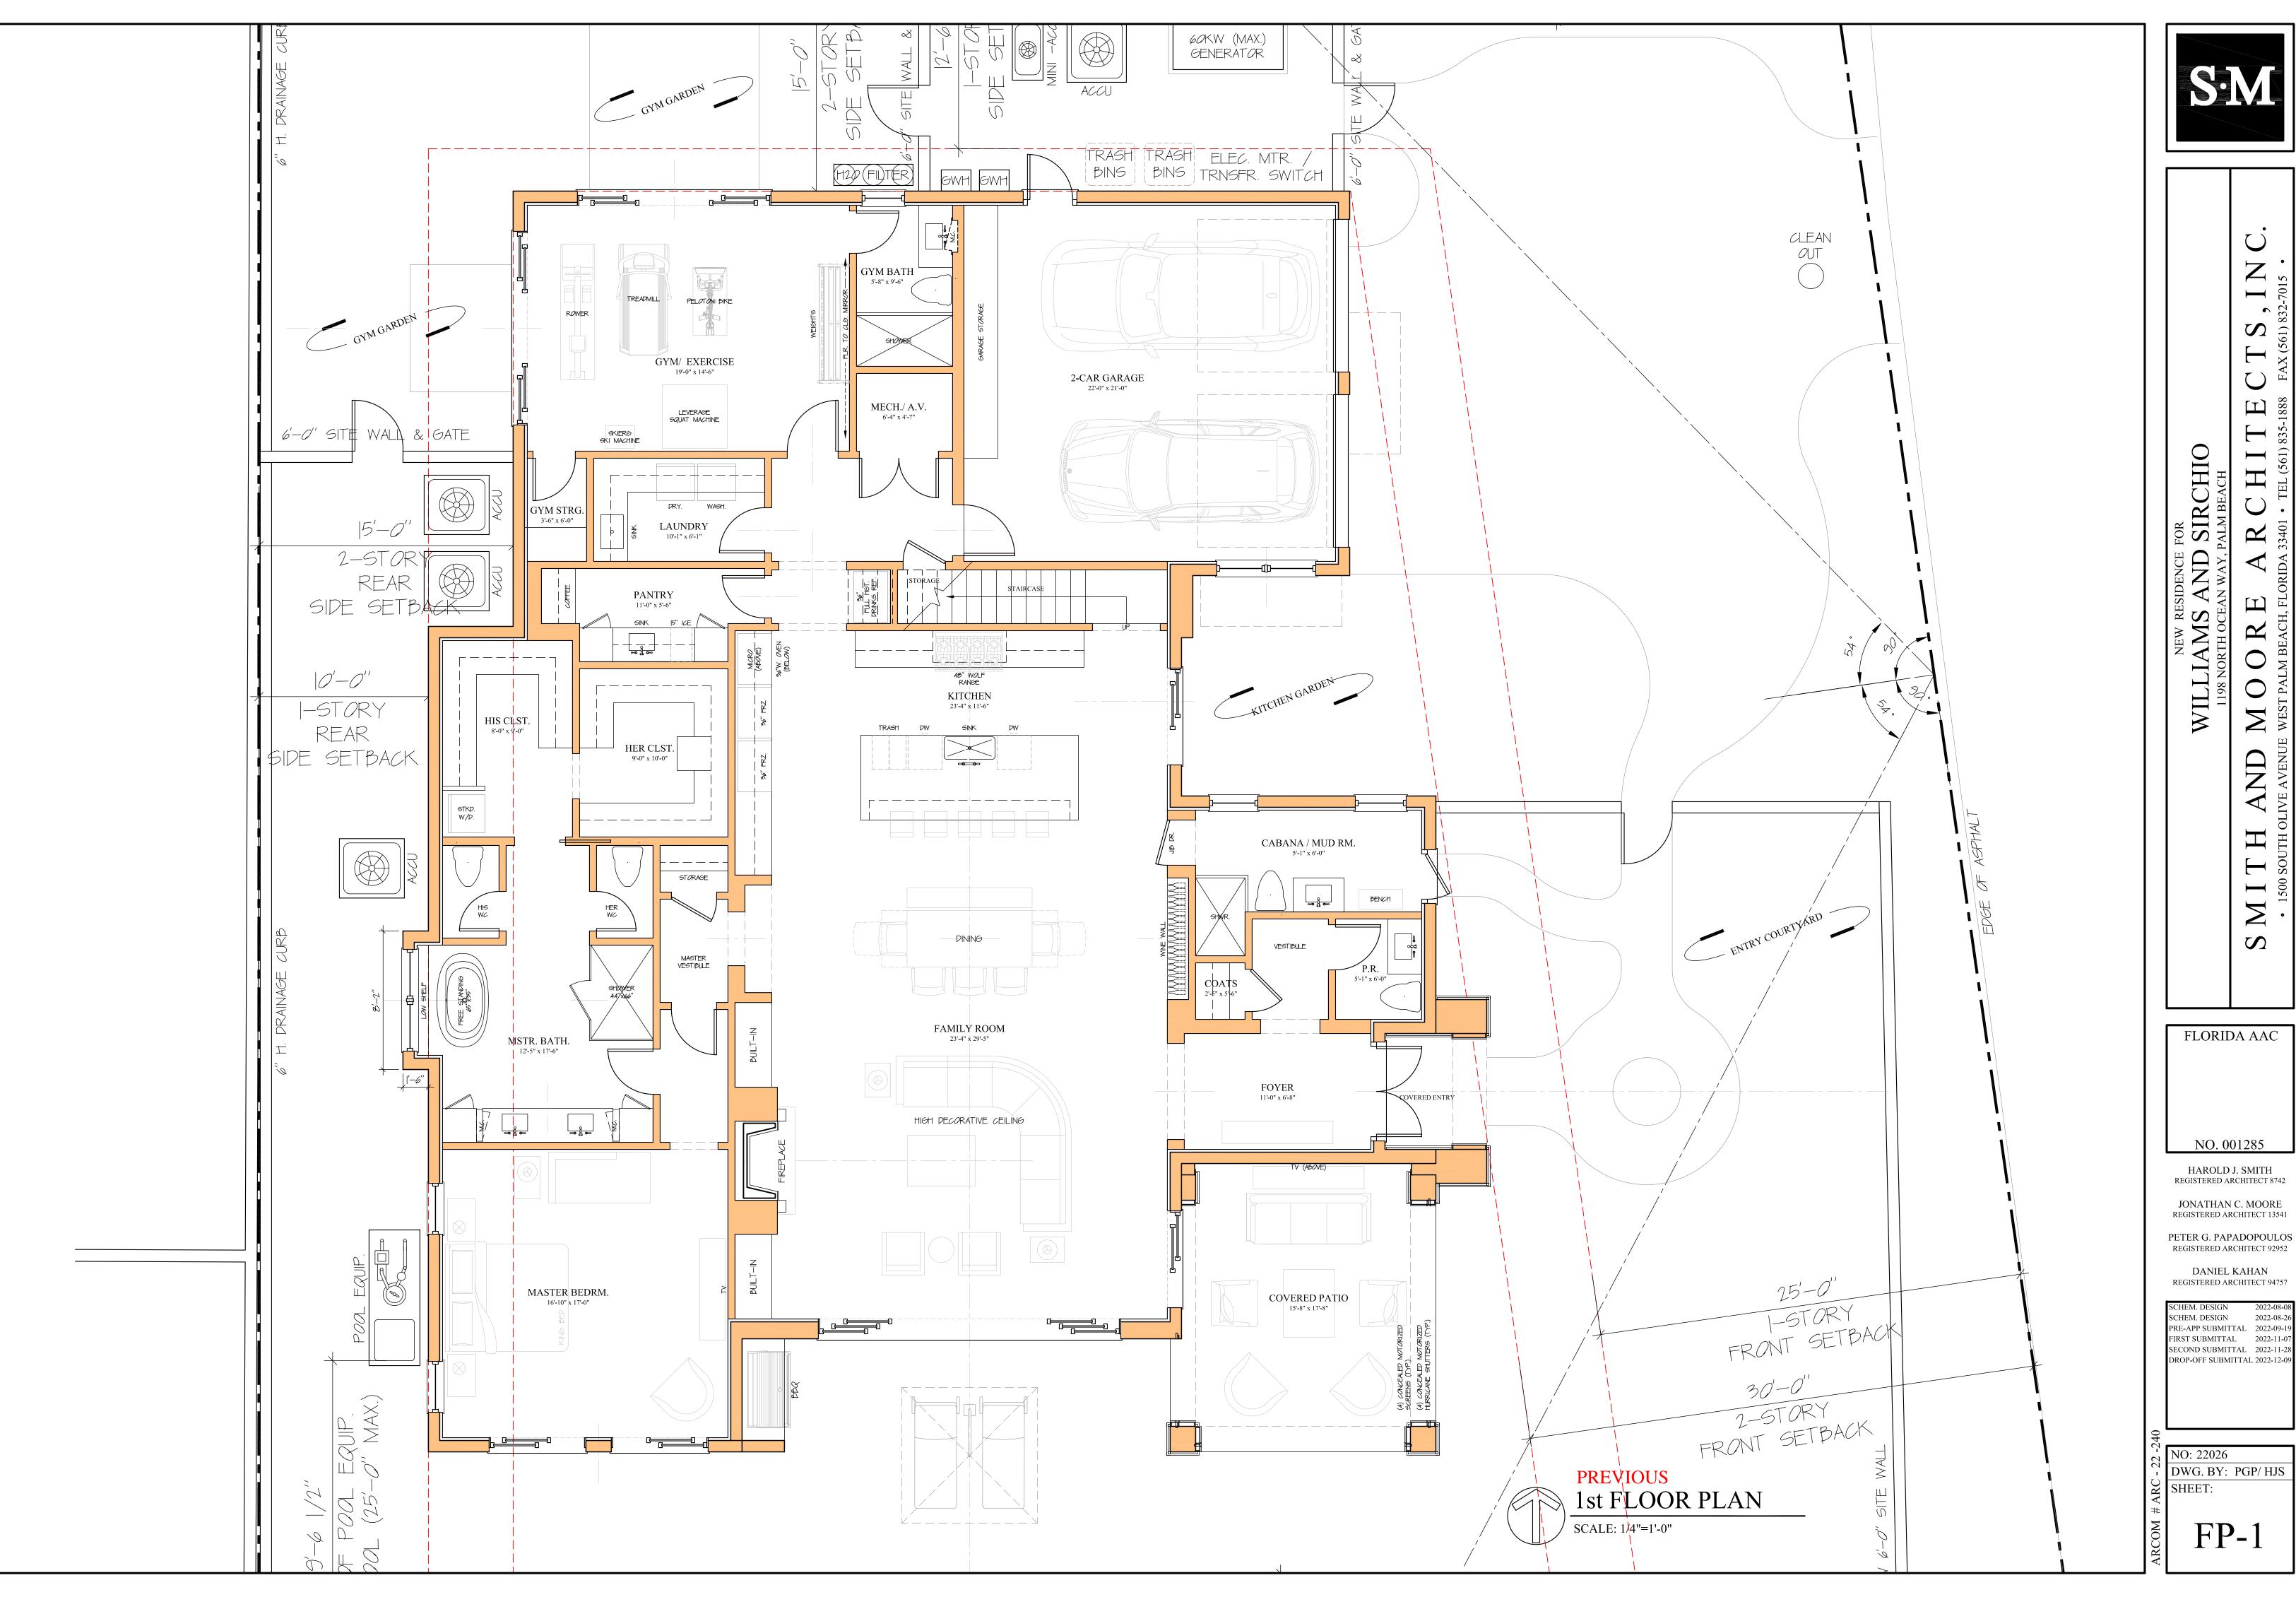

REGISTERED ARCHITECT 92952

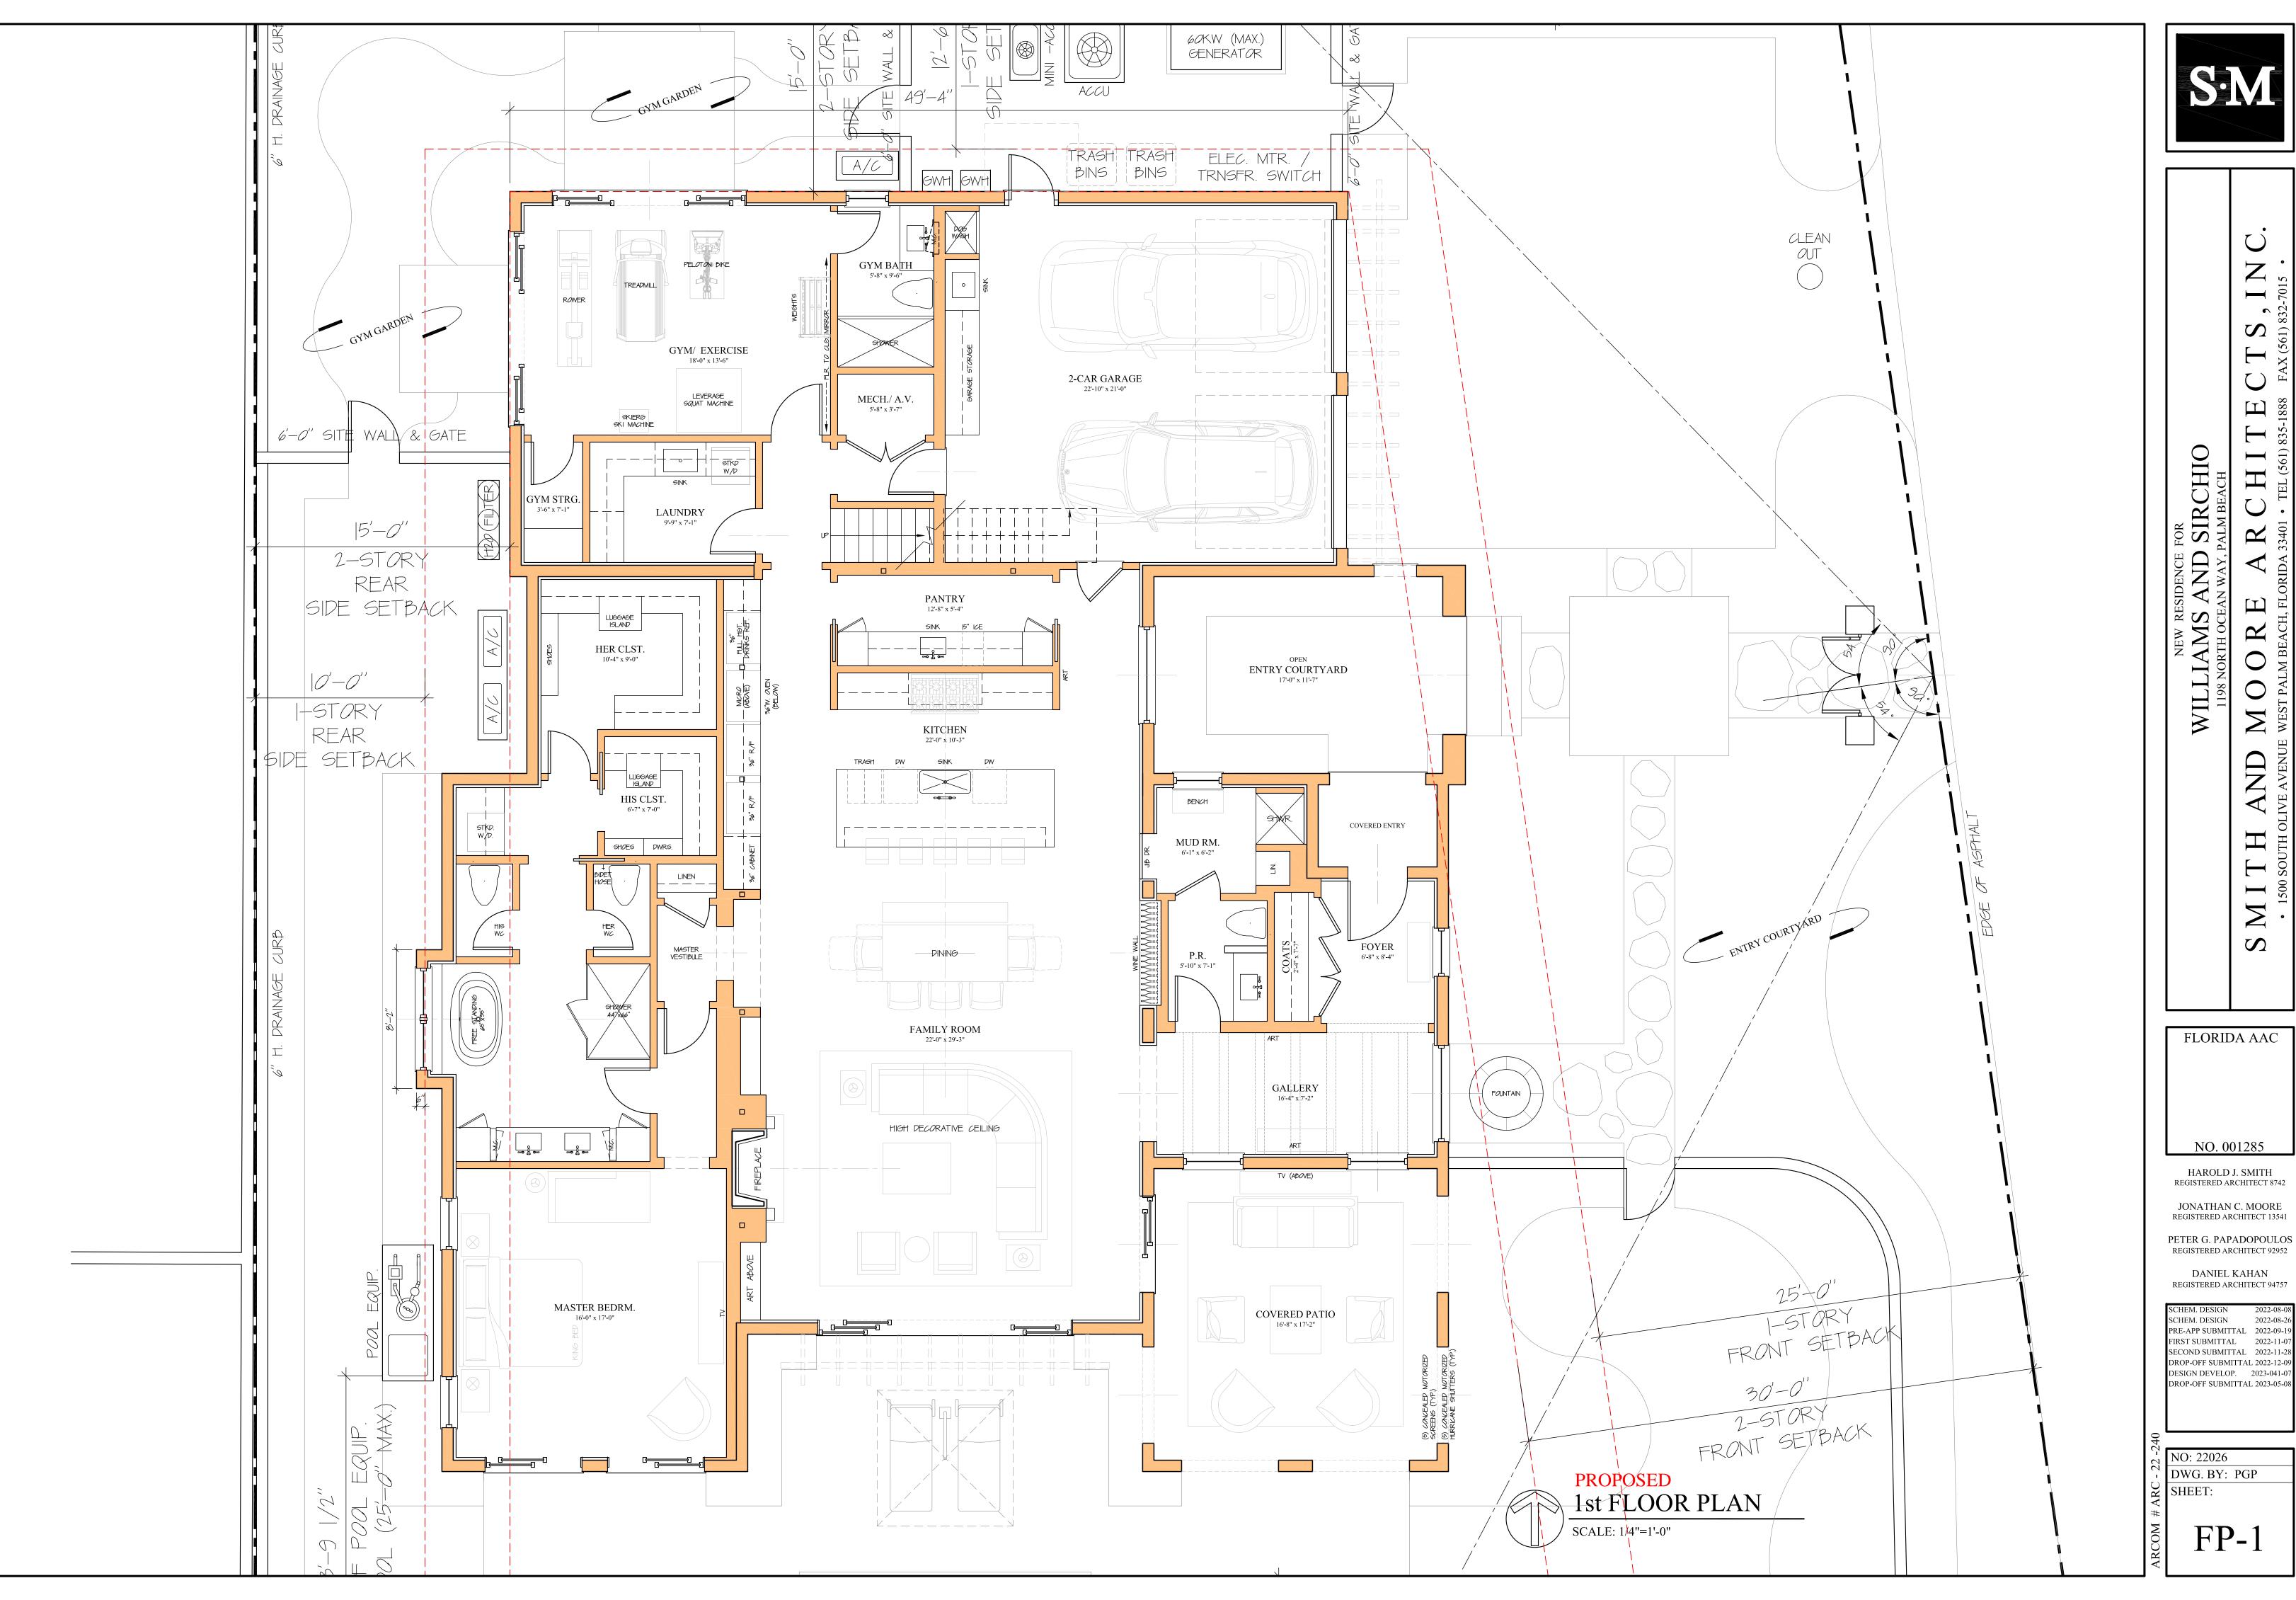

H

HAROLD J. SMITH REGISTERED ARCHITECT 8742


REGISTERED ARCHITECT 13541

REGISTERED ARCHITECT 92952

PRE-APP SUBMITTAL 2022-09-1 FIRST SUBMITTAL 2022-11-07 SECOND SUBMITTAL 2022-11-28 DROP-OFF SUBMITTAL 2022-12-09 DESIGN DEVELOP. 2023-041-07 DROP-OFF SUBMITTAL 2023-05-08

DWG. BY: PGP

FP-1

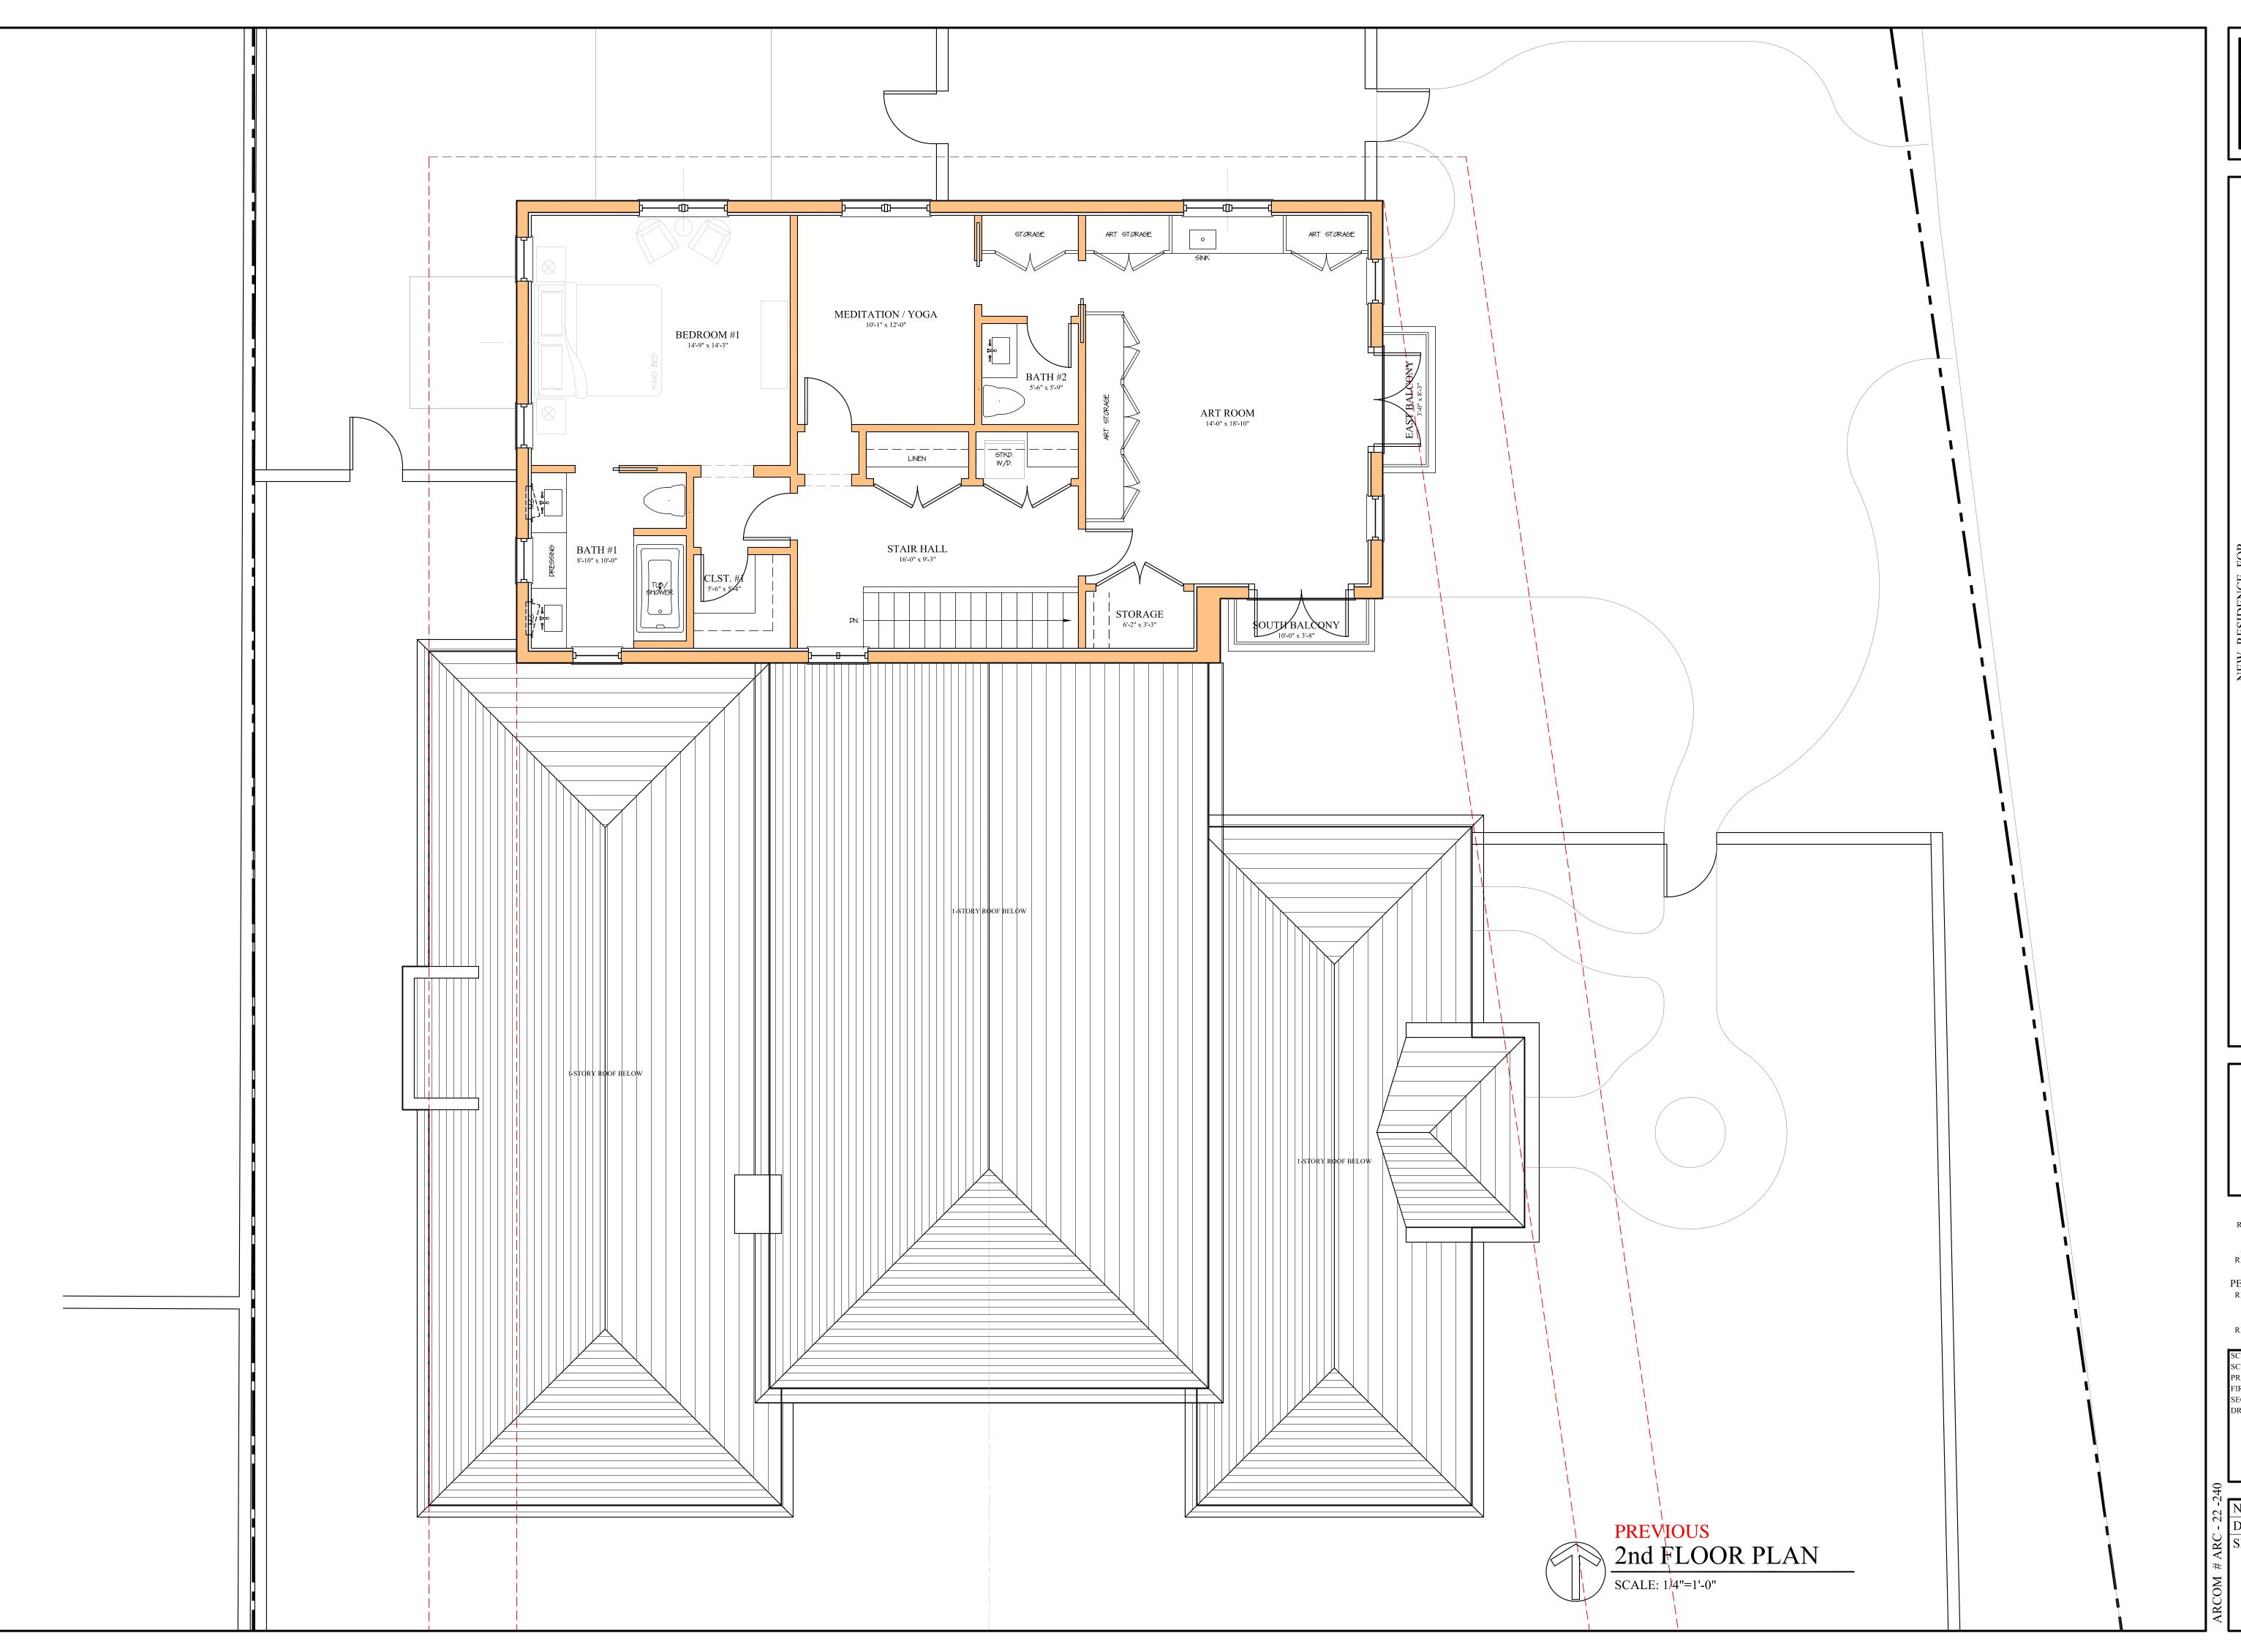

SM

WILLIAMS AND SIRCHIO

1198 NORTH OCEAN WAY, PALM BEACH

AND MOORE ARCHITECTS

FLORIDA AAC

NO. 001285

HAROLD J. SMITH
REGISTERED ARCHITECT 8742

JONATHAN C. MOORE REGISTERED ARCHITECT 13541

PETER G. PAPADOPOULOS REGISTERED ARCHITECT 92952

DANIEL KAHAN REGISTERED ARCHITECT 94757

 SCHEM. DESIGN
 2022-08-08

 SCHEM. DESIGN
 2022-08-26

 PRE-APP SUBMITTAL
 2022-09-19


 FIRST SUBMITTAL
 2022-11-07

 SECOND SUBMITTAL
 2022-11-28

 DROP-OFF SUBMITTAL
 2022-12-09

NO: 22026
DWG. BY: PGP/ HJS
SHEET:

FP-2

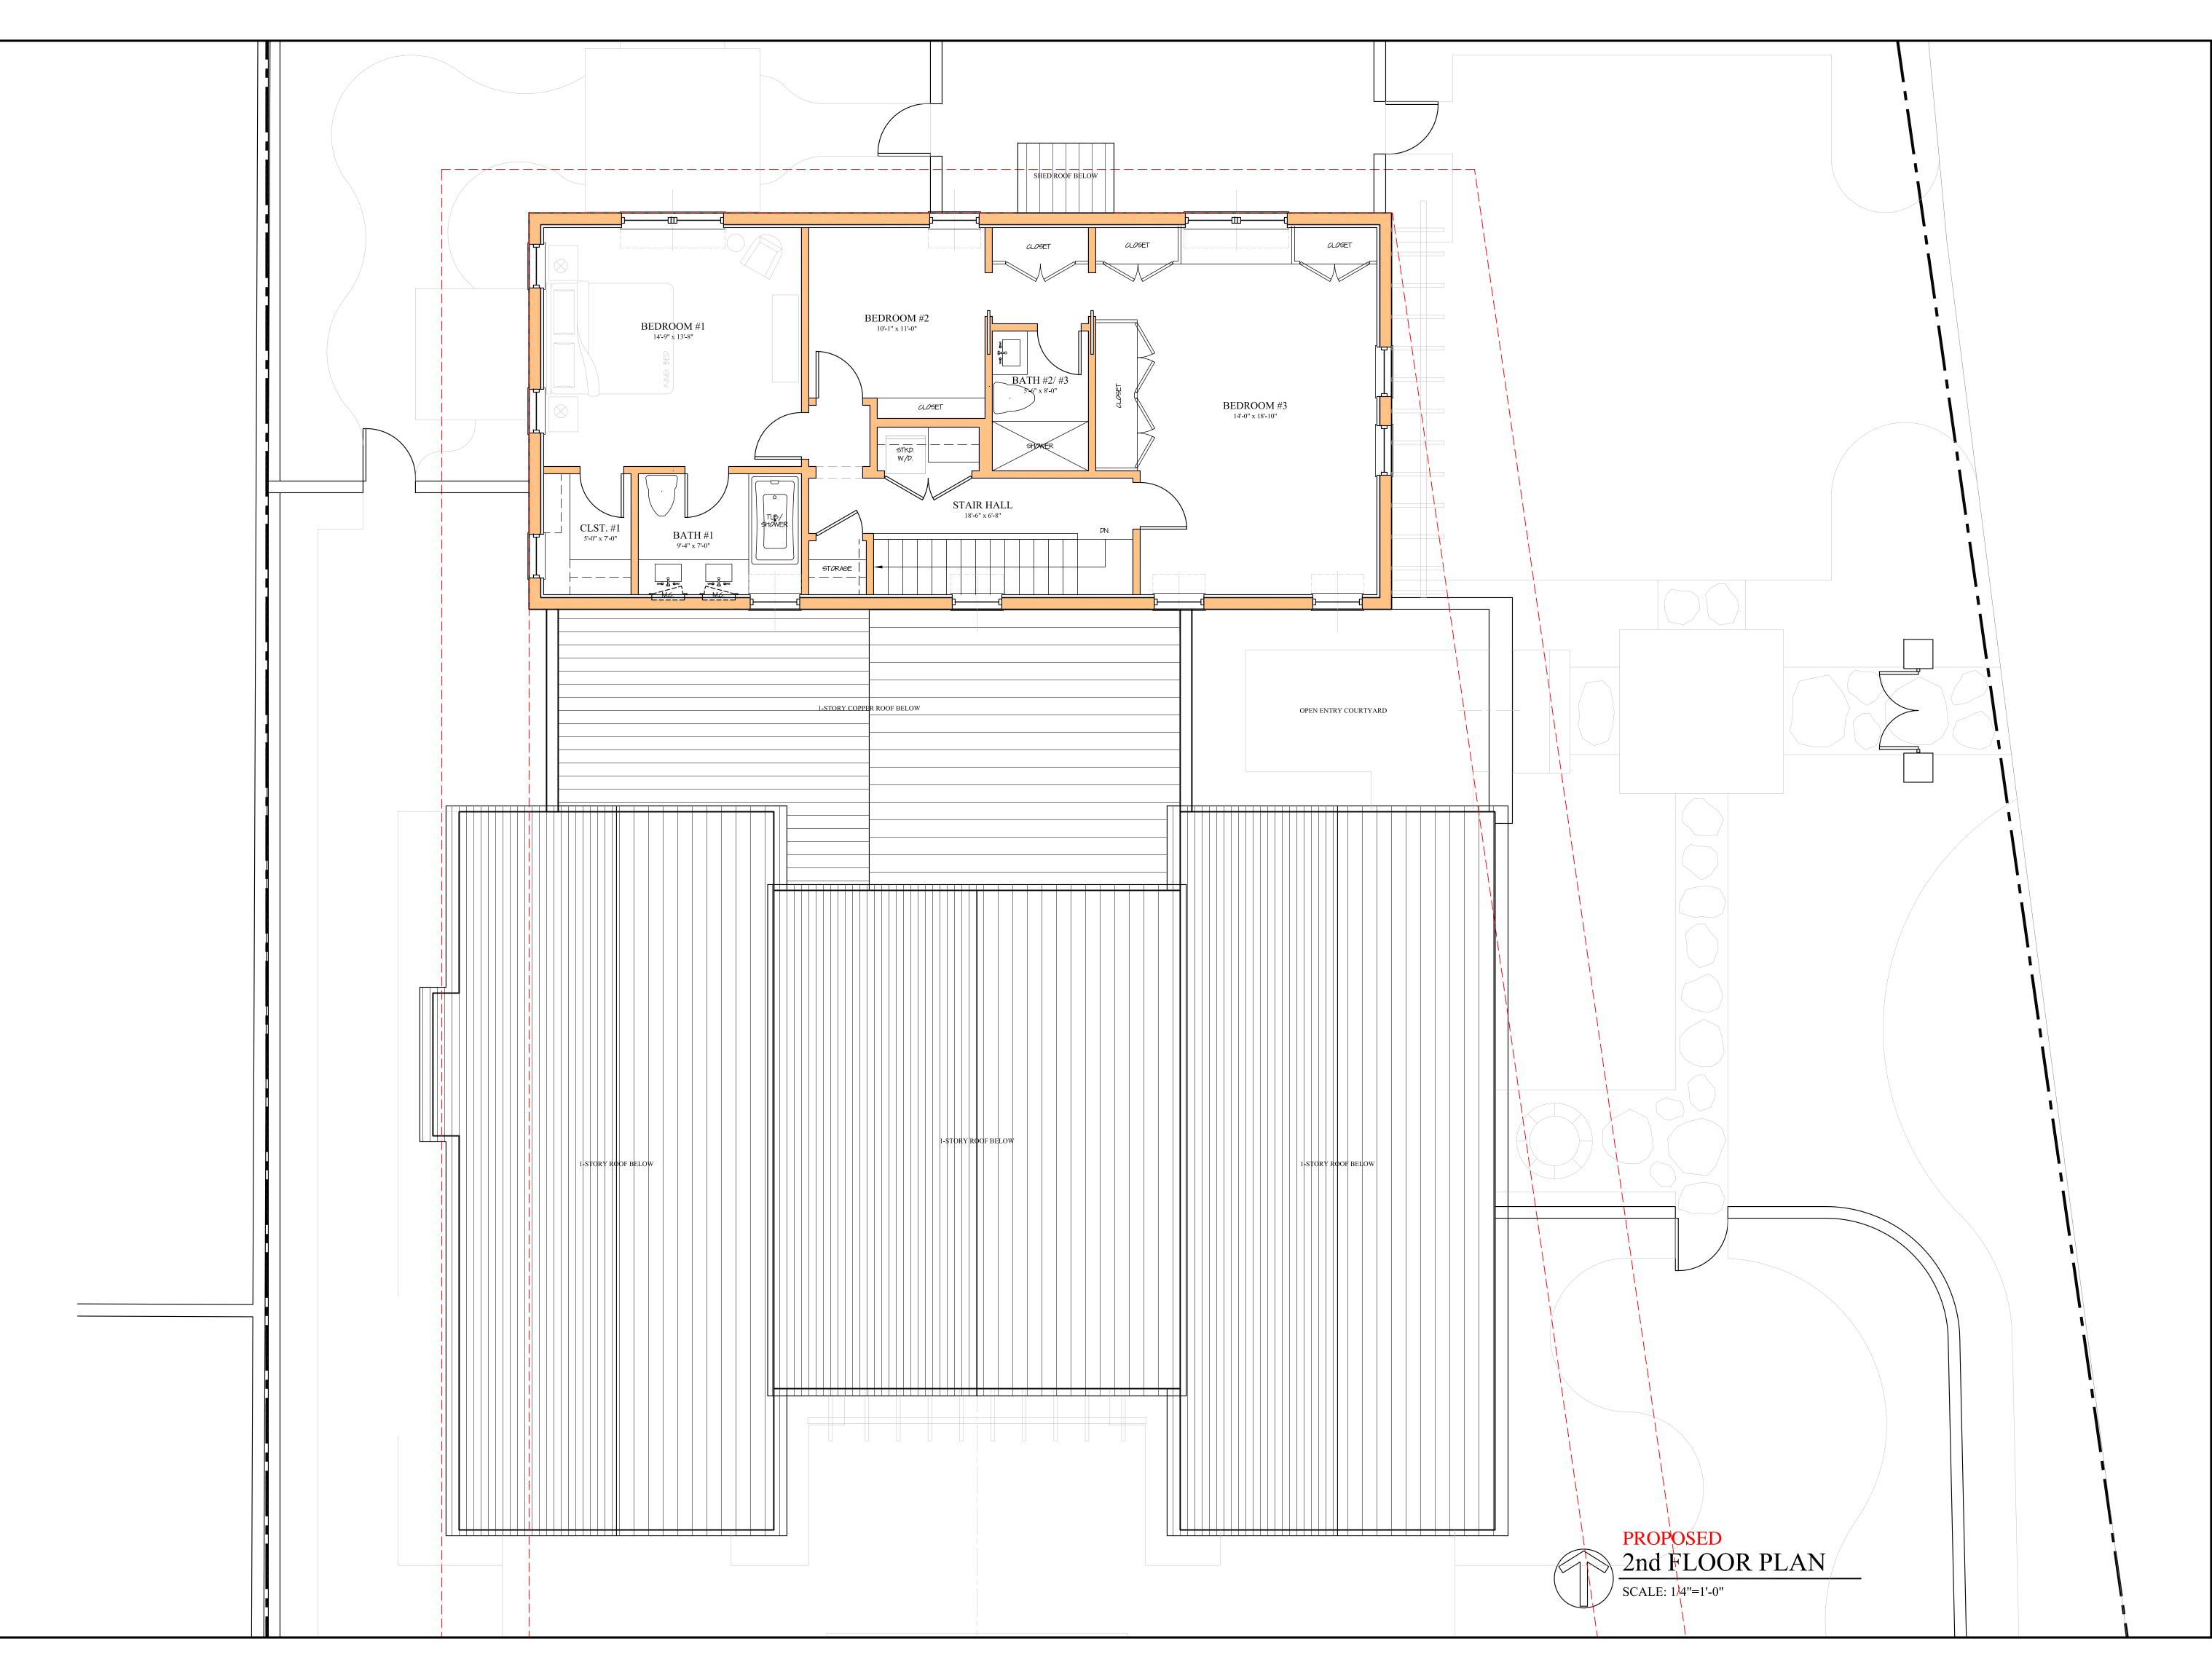



WILLIAMS AND SIRCHIO
1198 NORTH OCEAN WAY, PALM BEACH
ID MOOR FAR CHITFCTS I

FLORIDA AAC

NO. 001285

HAROLD J. SMITH
REGISTERED ARCHITECT 8742

JONATHAN C. MOORE

REGISTERED ARCHITECT 13541
PETER G. PAPADOPOULOS

REGISTERED ARCHITECT 92952

DANIEL KAHAN REGISTERED ARCHITECT 94757

 SCHEM. DESIGN
 2022-08-08

 SCHEM. DESIGN
 2022-08-26

 PRE-APP SUBMITTAL
 2022-09-19

 FIRST SUBMITTAL
 2022-11-07

 SECOND SUBMITTAL
 2022-11-28


 DROP-OFF SUBMITTAL
 2022-12-09

 DESIGN DEVELOP.
 2023-041-07

 DROP-OFF SUBMITTAL
 2023-05-08

947-27 NO: 22026 DWG. BY: PGP SHEET:

FP-2

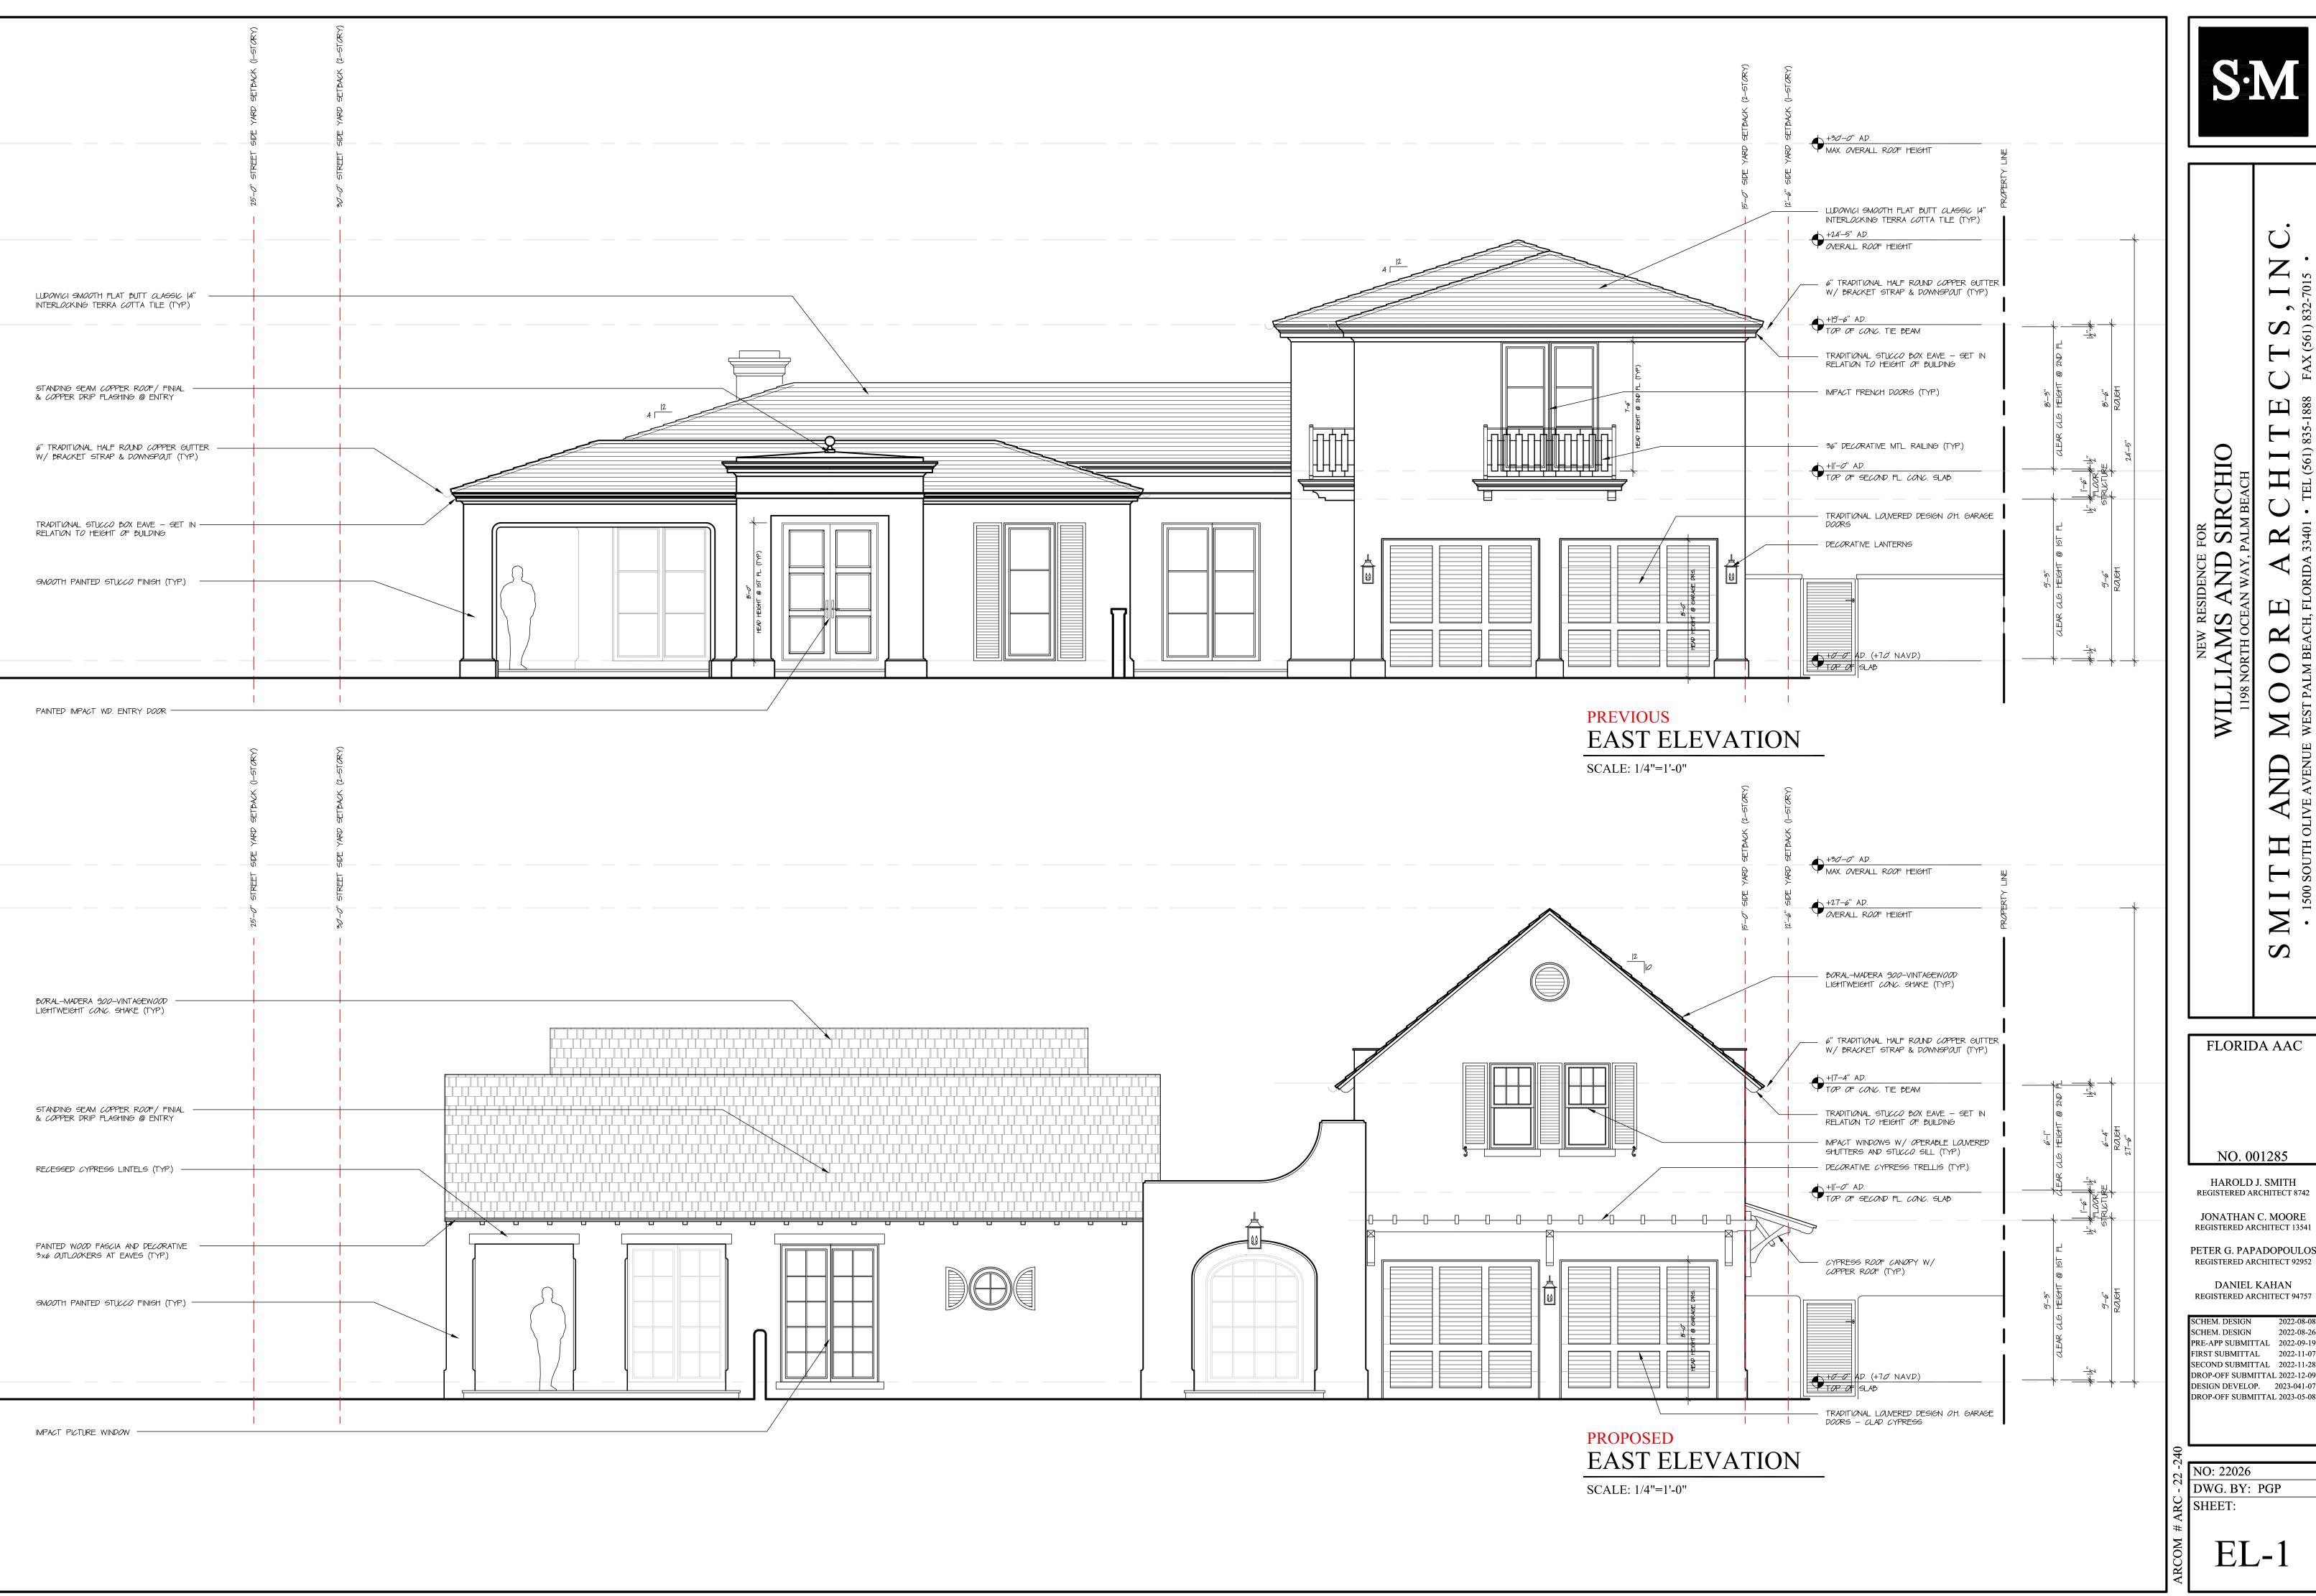

口

FLORIDA AAC

HAROLD J. SMITH REGISTERED ARCHITECT 8742


REGISTERED ARCHITECT 13541 PETER G. PAPADOPOULOS


REGISTERED ARCHITECT 92952 DANIEL KAHAN

SCHEM. DESIGN 2022-08-26 PRE-APP SUBMITTAL 2022-09-19

FIRST SUBMITTAL 2022-11-07 SECOND SUBMITTAL 2022-11-28 DROP-OFF SUBMITTAL 2022-12-09 DESIGN DEVELOP. 2023-041-07 DROP-OFF SUBMITTAL 2023-05-08

DWG. BY: PGP

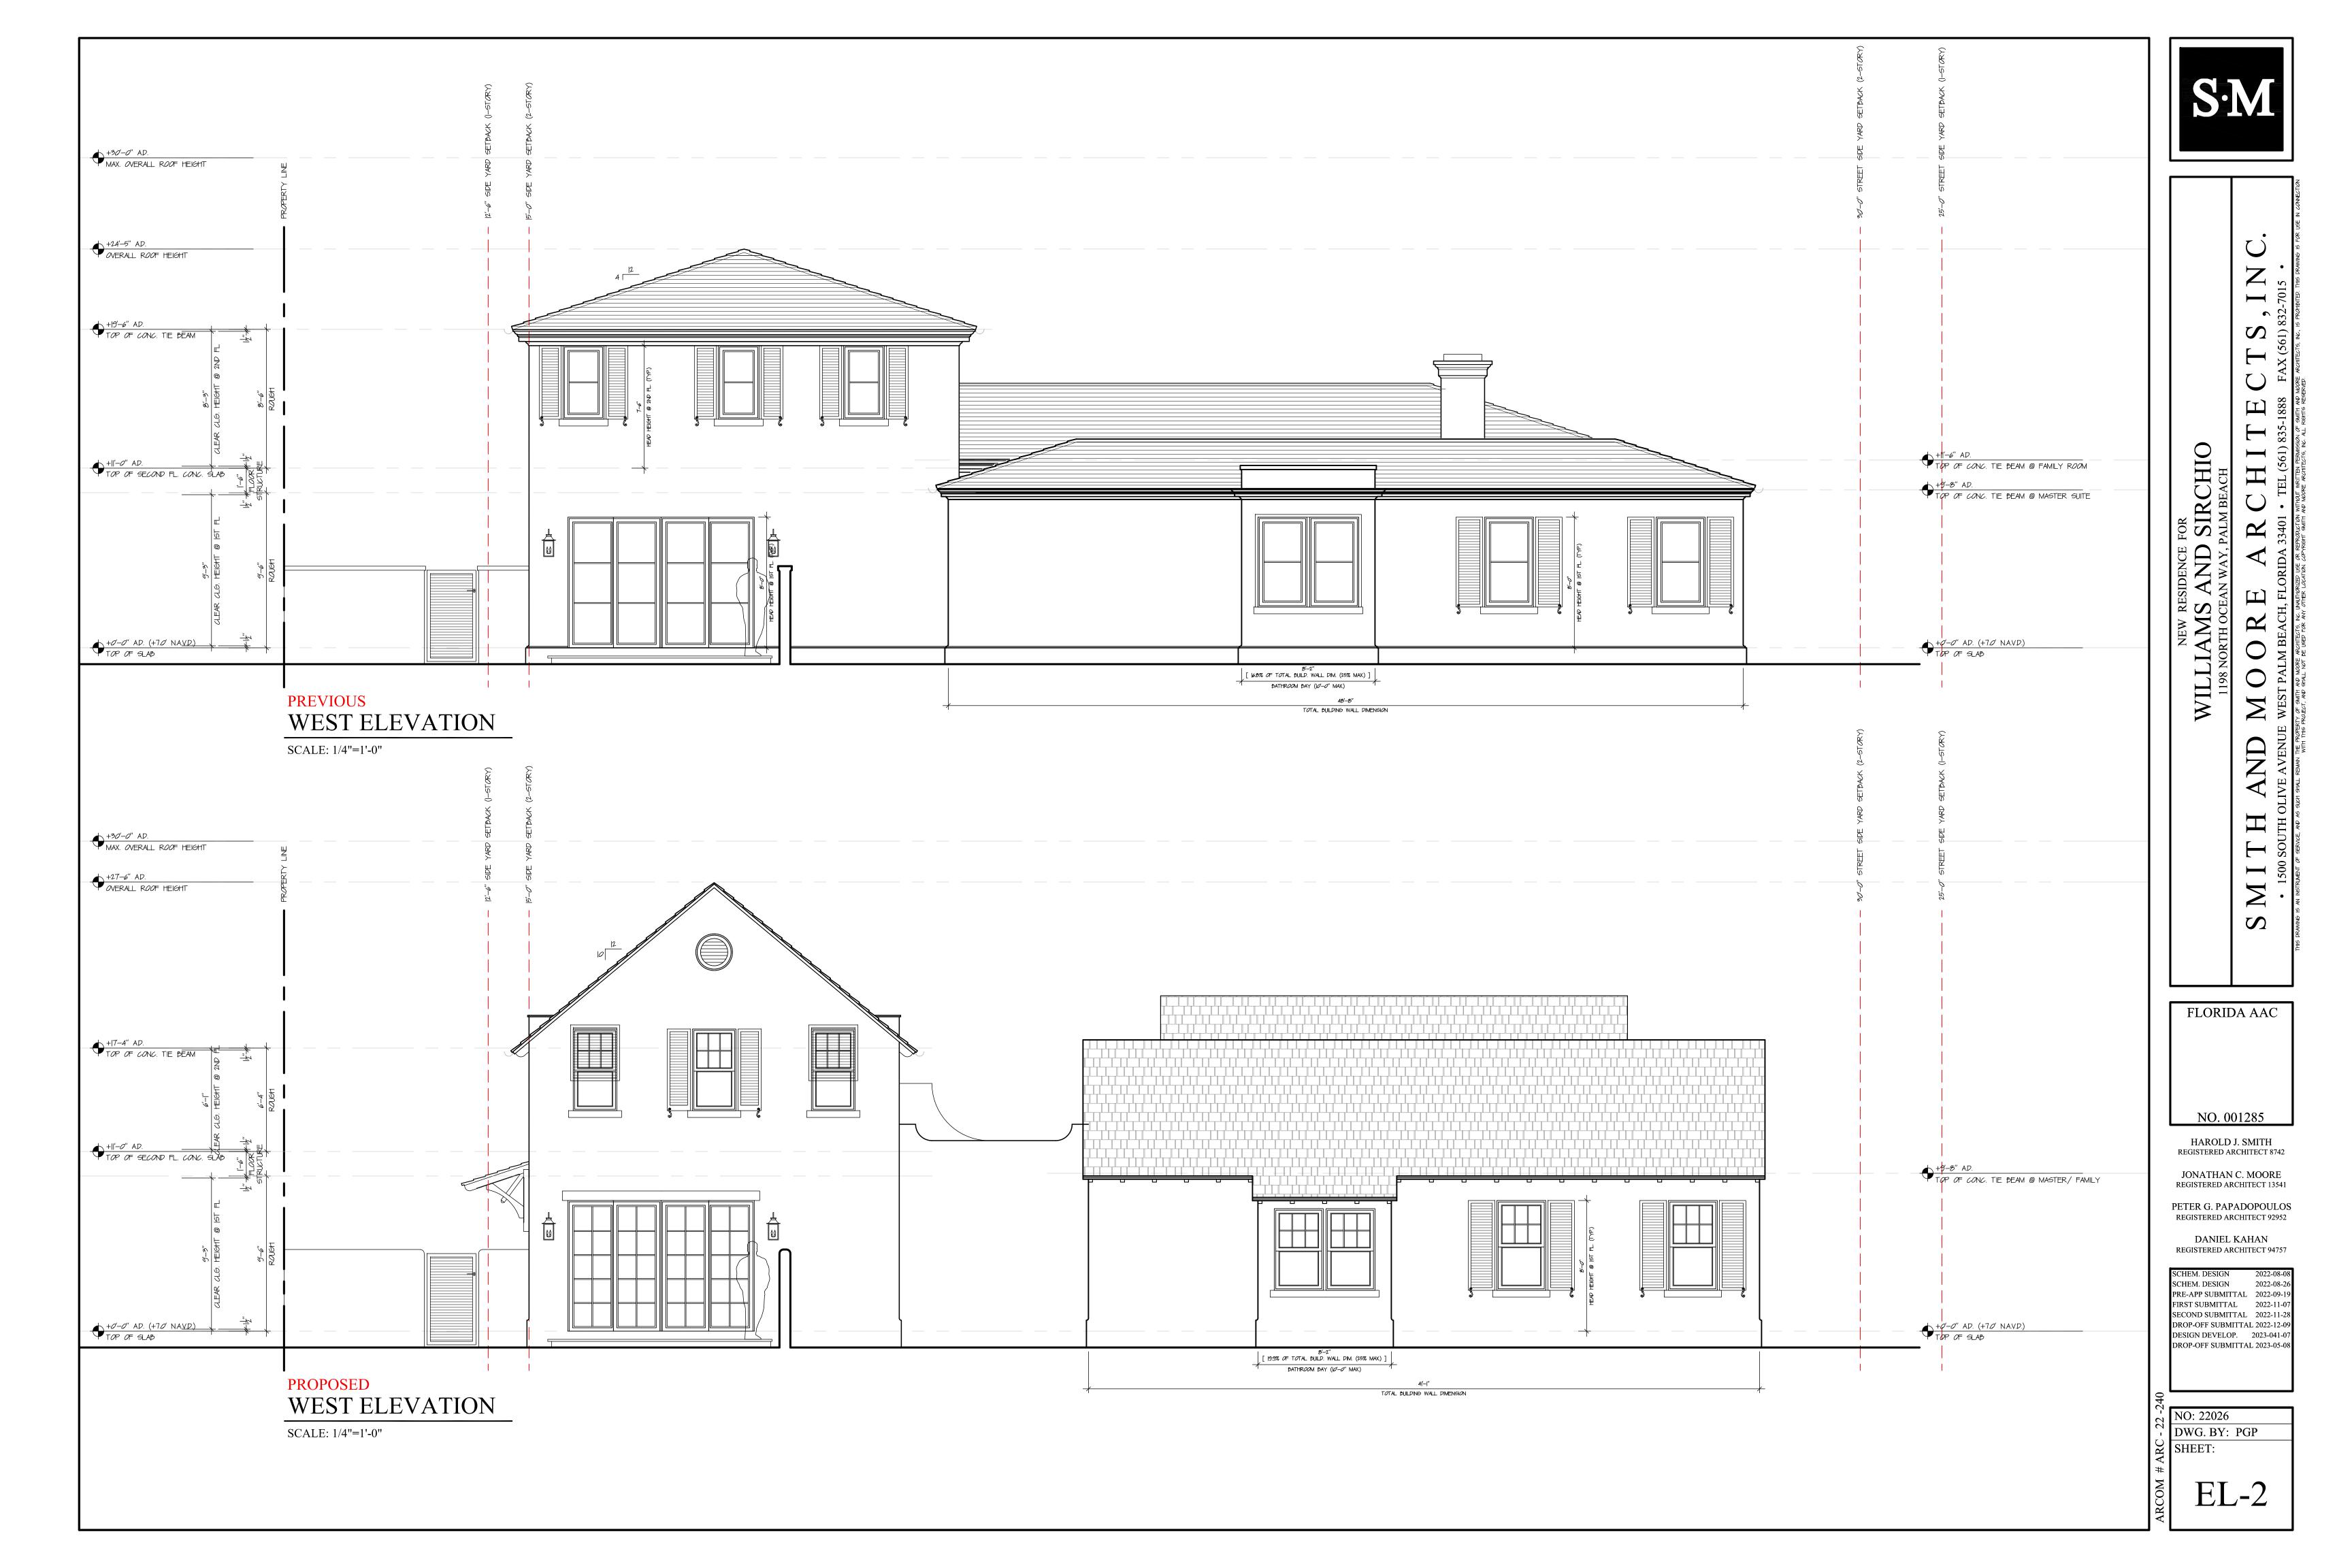

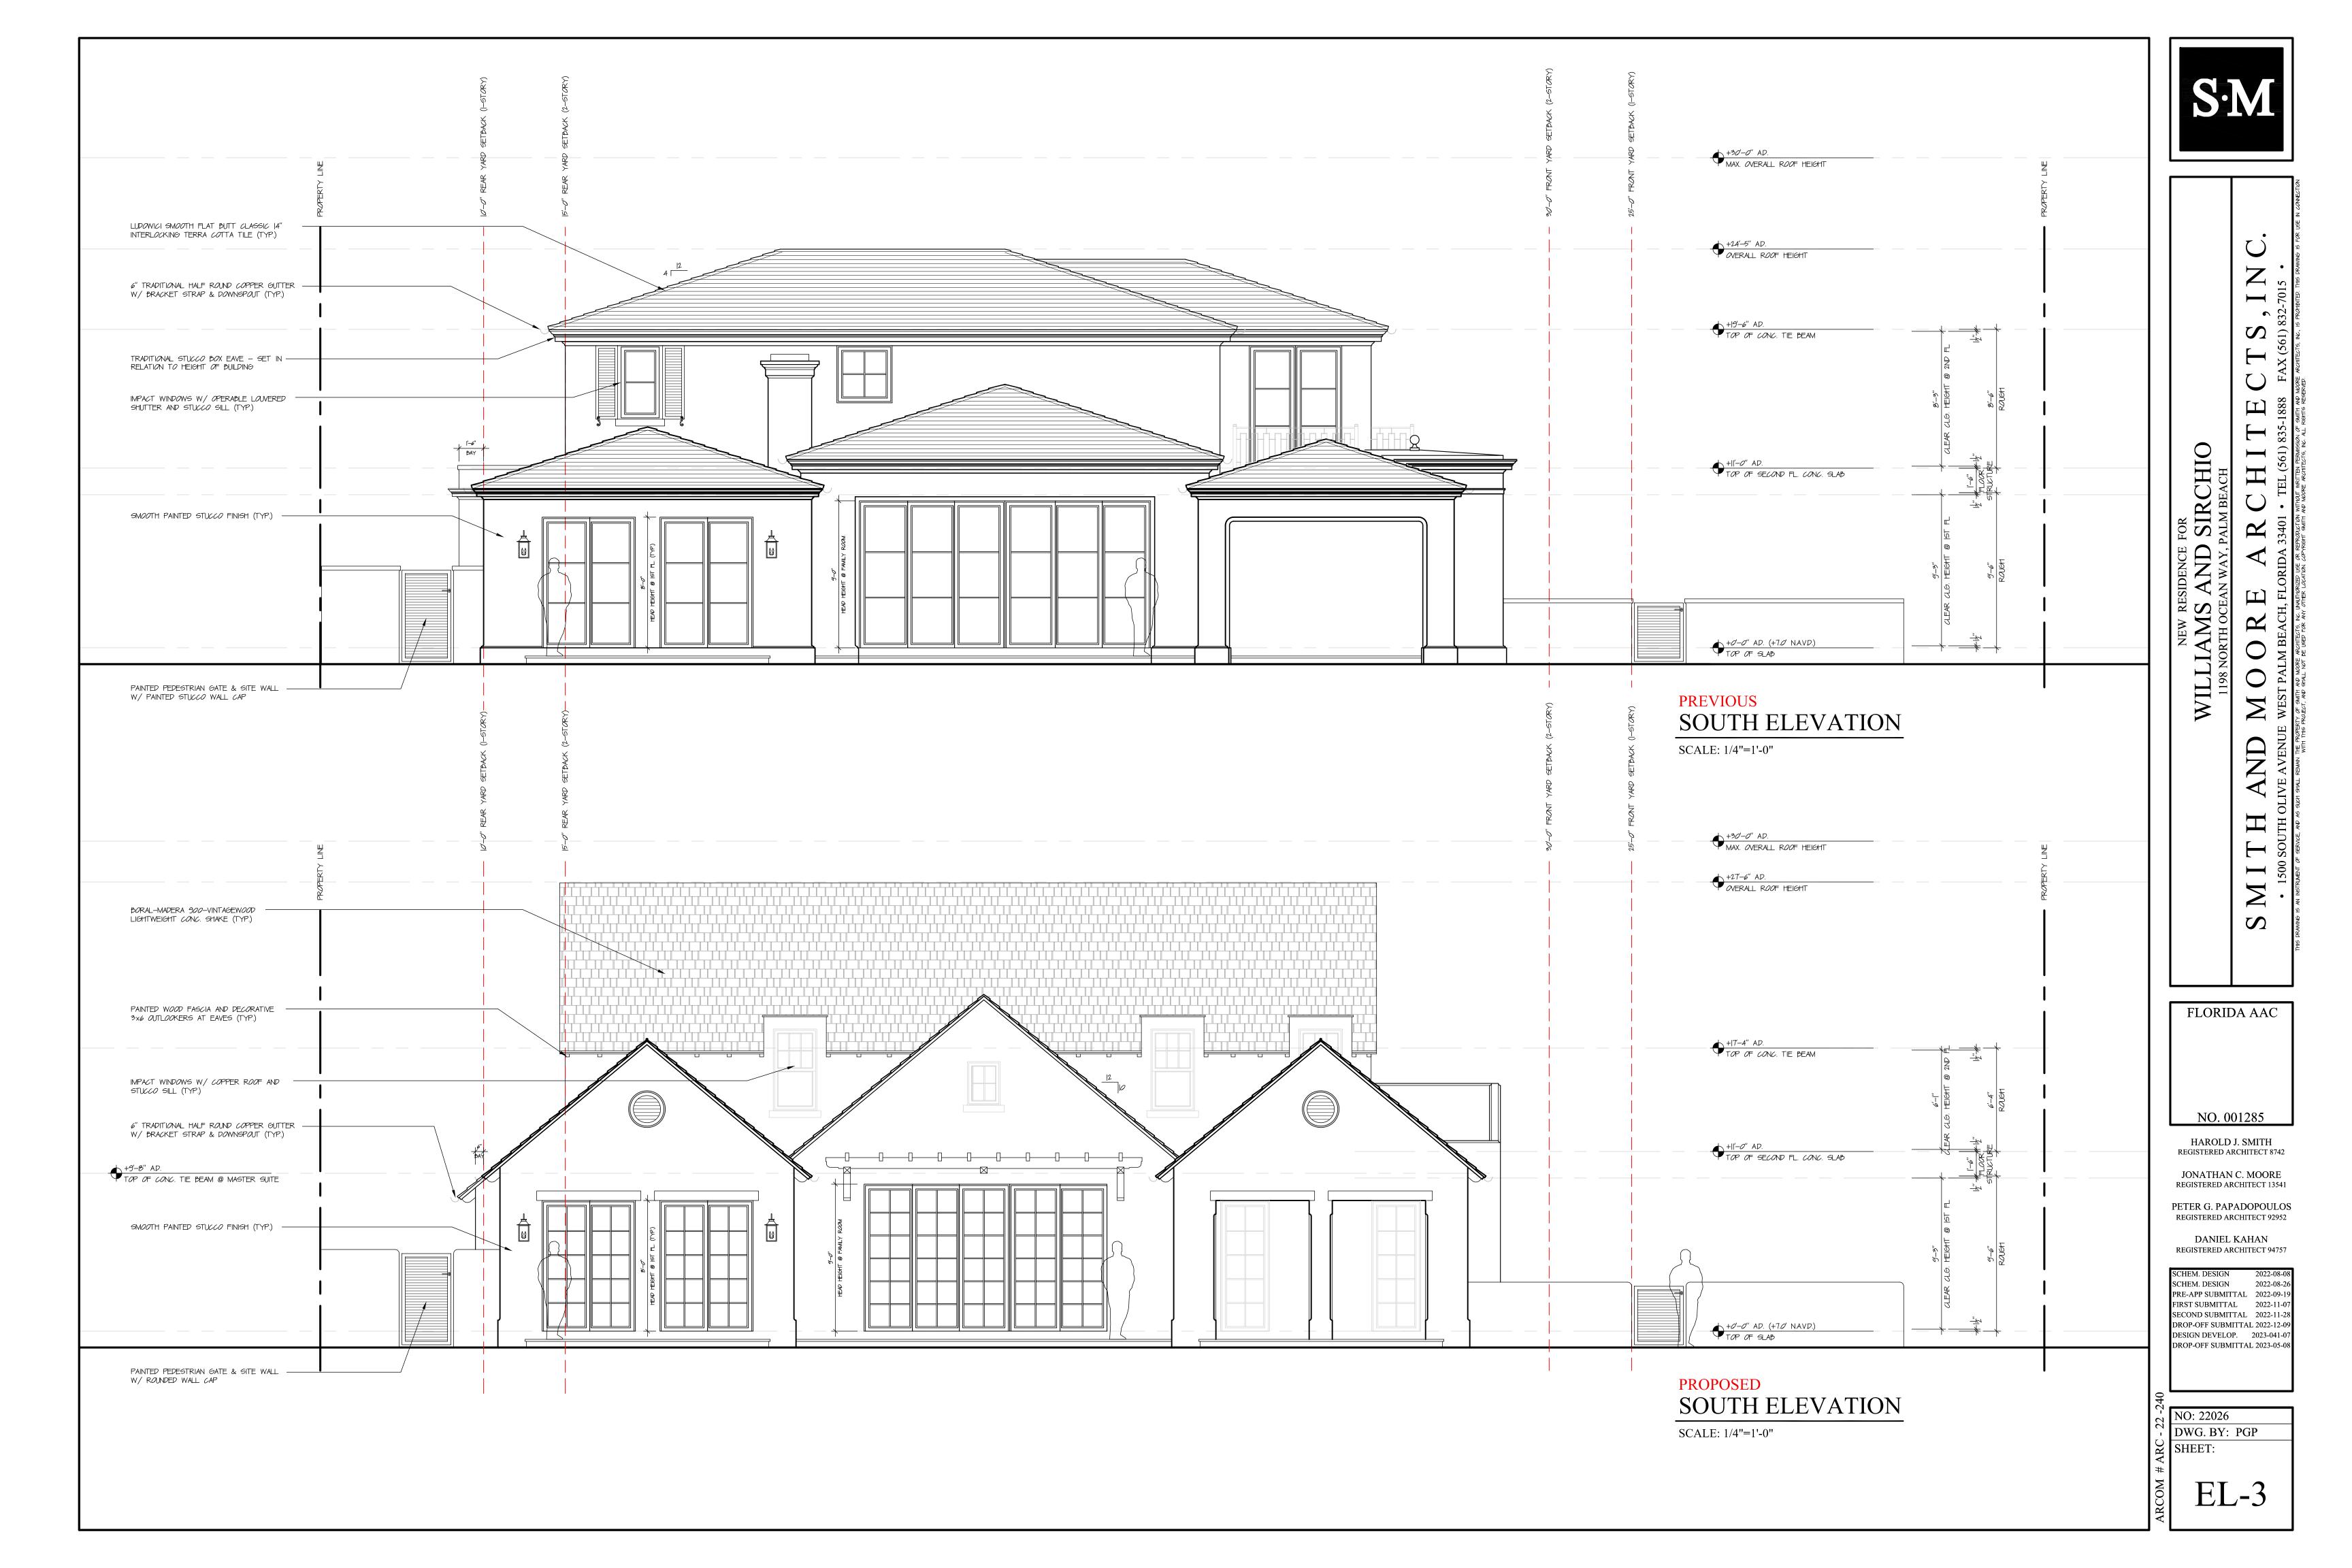



WILLIAMS AND SIRCHIO
1198 NORTH OCEAN WAY, PALM BEACH

FLORIDA AAC

NO. 001285

HAROLD J. SMITH REGISTERED ARCHITECT 8742

JONATHAN C. MOORE REGISTERED ARCHITECT 13541

PETER G. PAPADOPOULOS REGISTERED ARCHITECT 92952

> DANIEL KAHAN REGISTERED ARCHITECT 94

 SCHEM. DESIGN
 2022-08-08

 SCHEM. DESIGN
 2022-08-26

 PRE-APP SUBMITTAL
 2022-09-19

 FIRST SUBMITTAL
 2022-11-07

 SECOND SUBMITTAL
 2022-11-28

 DROP-OFF SUBMITTAL
 2022-12-09

 DESIGN DEVELOP.
 2023-041-07

 DROP-OFF SUBMITTAL
 2023-05-08

**R-1** 

NO: 22026
DWG. BY: PGP
SHEET:

COM # ARC - 22 -240









NO. 001285 HAROLD J. SMITH REGISTERED ARCHITECT 8742

JONATHAN C. MOORE REGISTERED ARCHITECT 13541

PETER G. PAPADOPOULOS REGISTERED ARCHITECT 92952

DANIEL KAHAN REGISTERED ARCHITECT 94757

FIRST SUBMITTAL 2022-11-07 SECOND SUBMITTAL 2022-11-28 DROP-OFF SUBMITTAL 2022-12-09 DESIGN DEVELOP. 2023-041-07 DROP-OFF SUBMITTAL 2023-05-08

NO: 22026 DWG. BY: PGP SHEET:

R-2



 $\vdash$ 

S

NO. 001285 HAROLD J. SMITH REGISTERED ARCHITECT 8742

JONATHAN C. MOORE REGISTERED ARCHITECT 13541

PETER G. PAPADOPOULOS REGISTERED ARCHITECT 92952

DANIEL KAHAN REGISTERED ARCHITECT 94757

FIRST SUBMITTAL 2022-11-07 SECOND SUBMITTAL 2022-11-28 DROP-OFF SUBMITTAL 2022-12-09 DESIGN DEVELOP. 2023-041-07 DROP-OFF SUBMITTAL 2023-05-08

R-3

NO: 22026 DWG. BY: PGP SHEET:





NO. 001285

HAROLD J. SMITH REGISTERED ARCHITECT 8742 JONATHAN C. MOORE REGISTERED ARCHITECT 13541


PETER G. PAPADOPOULOS REGISTERED ARCHITECT 92952

DANIEL KAHAN REGISTERED ARCHITECT 94757

FIRST SUBMITTAL 2022-11-07 SECOND SUBMITTAL 2022-11-28 DROP-OFF SUBMITTAL 2022-12-09 DESIGN DEVELOP. 2023-041-07 DROP-OFF SUBMITTAL 2023-05-08

NO: 22026 DWG. BY: PGP SHEET:

R-5

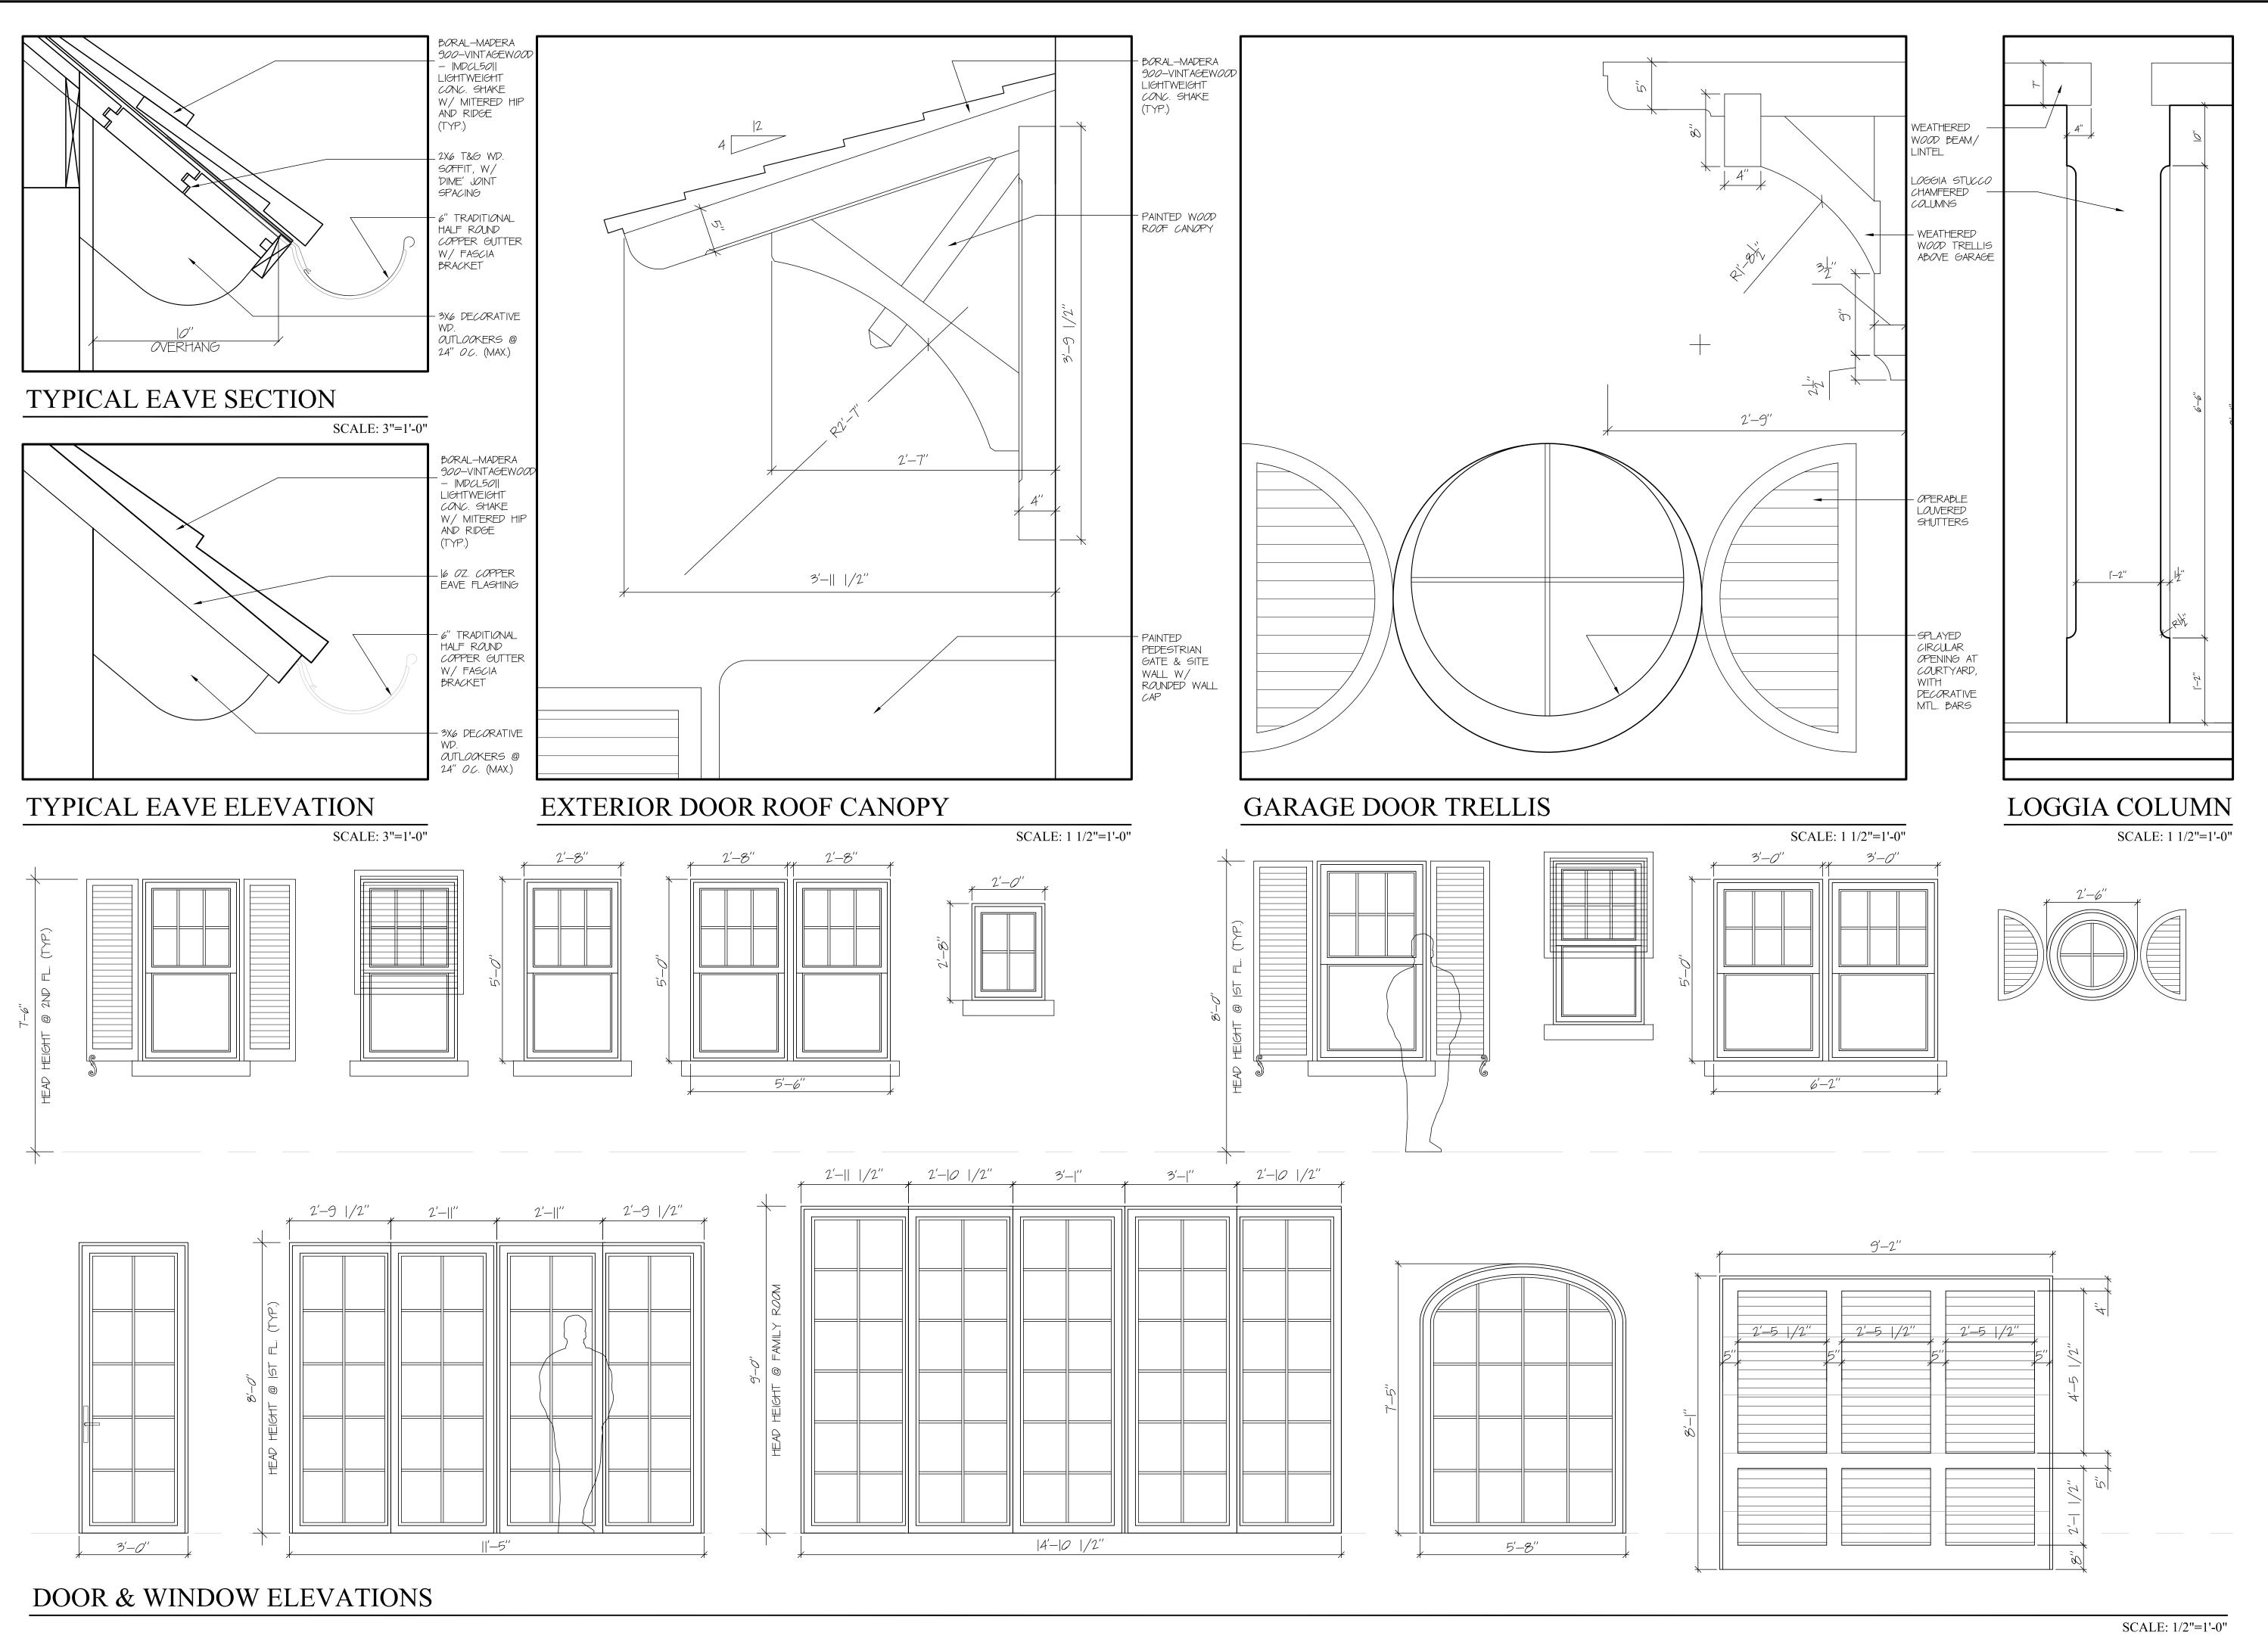

口

FLORIDA AAC NO. 001285

HAROLD J. SMITH REGISTERED ARCHITECT 8742

JONATHAN C. MOORE REGISTERED ARCHITECT 13541

PETER G. PAPADOPOULOS REGISTERED ARCHITECT 92952

DANIEL KAHAN


REGISTERED ARCHITECT 94757

SCHEM. DESIGN PRE-APP SUBMITTAL 2022-09-19 FIRST SUBMITTAL 2022-11-07 SECOND SUBMITTAL 2022-11-28 DROP-OFF SUBMITTAL 2022-12-09

DESIGN DEVELOP. 2023-041-07 DROP-OFF SUBMITTAL 2023-05-08

NO: 22026 DWG. BY: PGP SHEET:



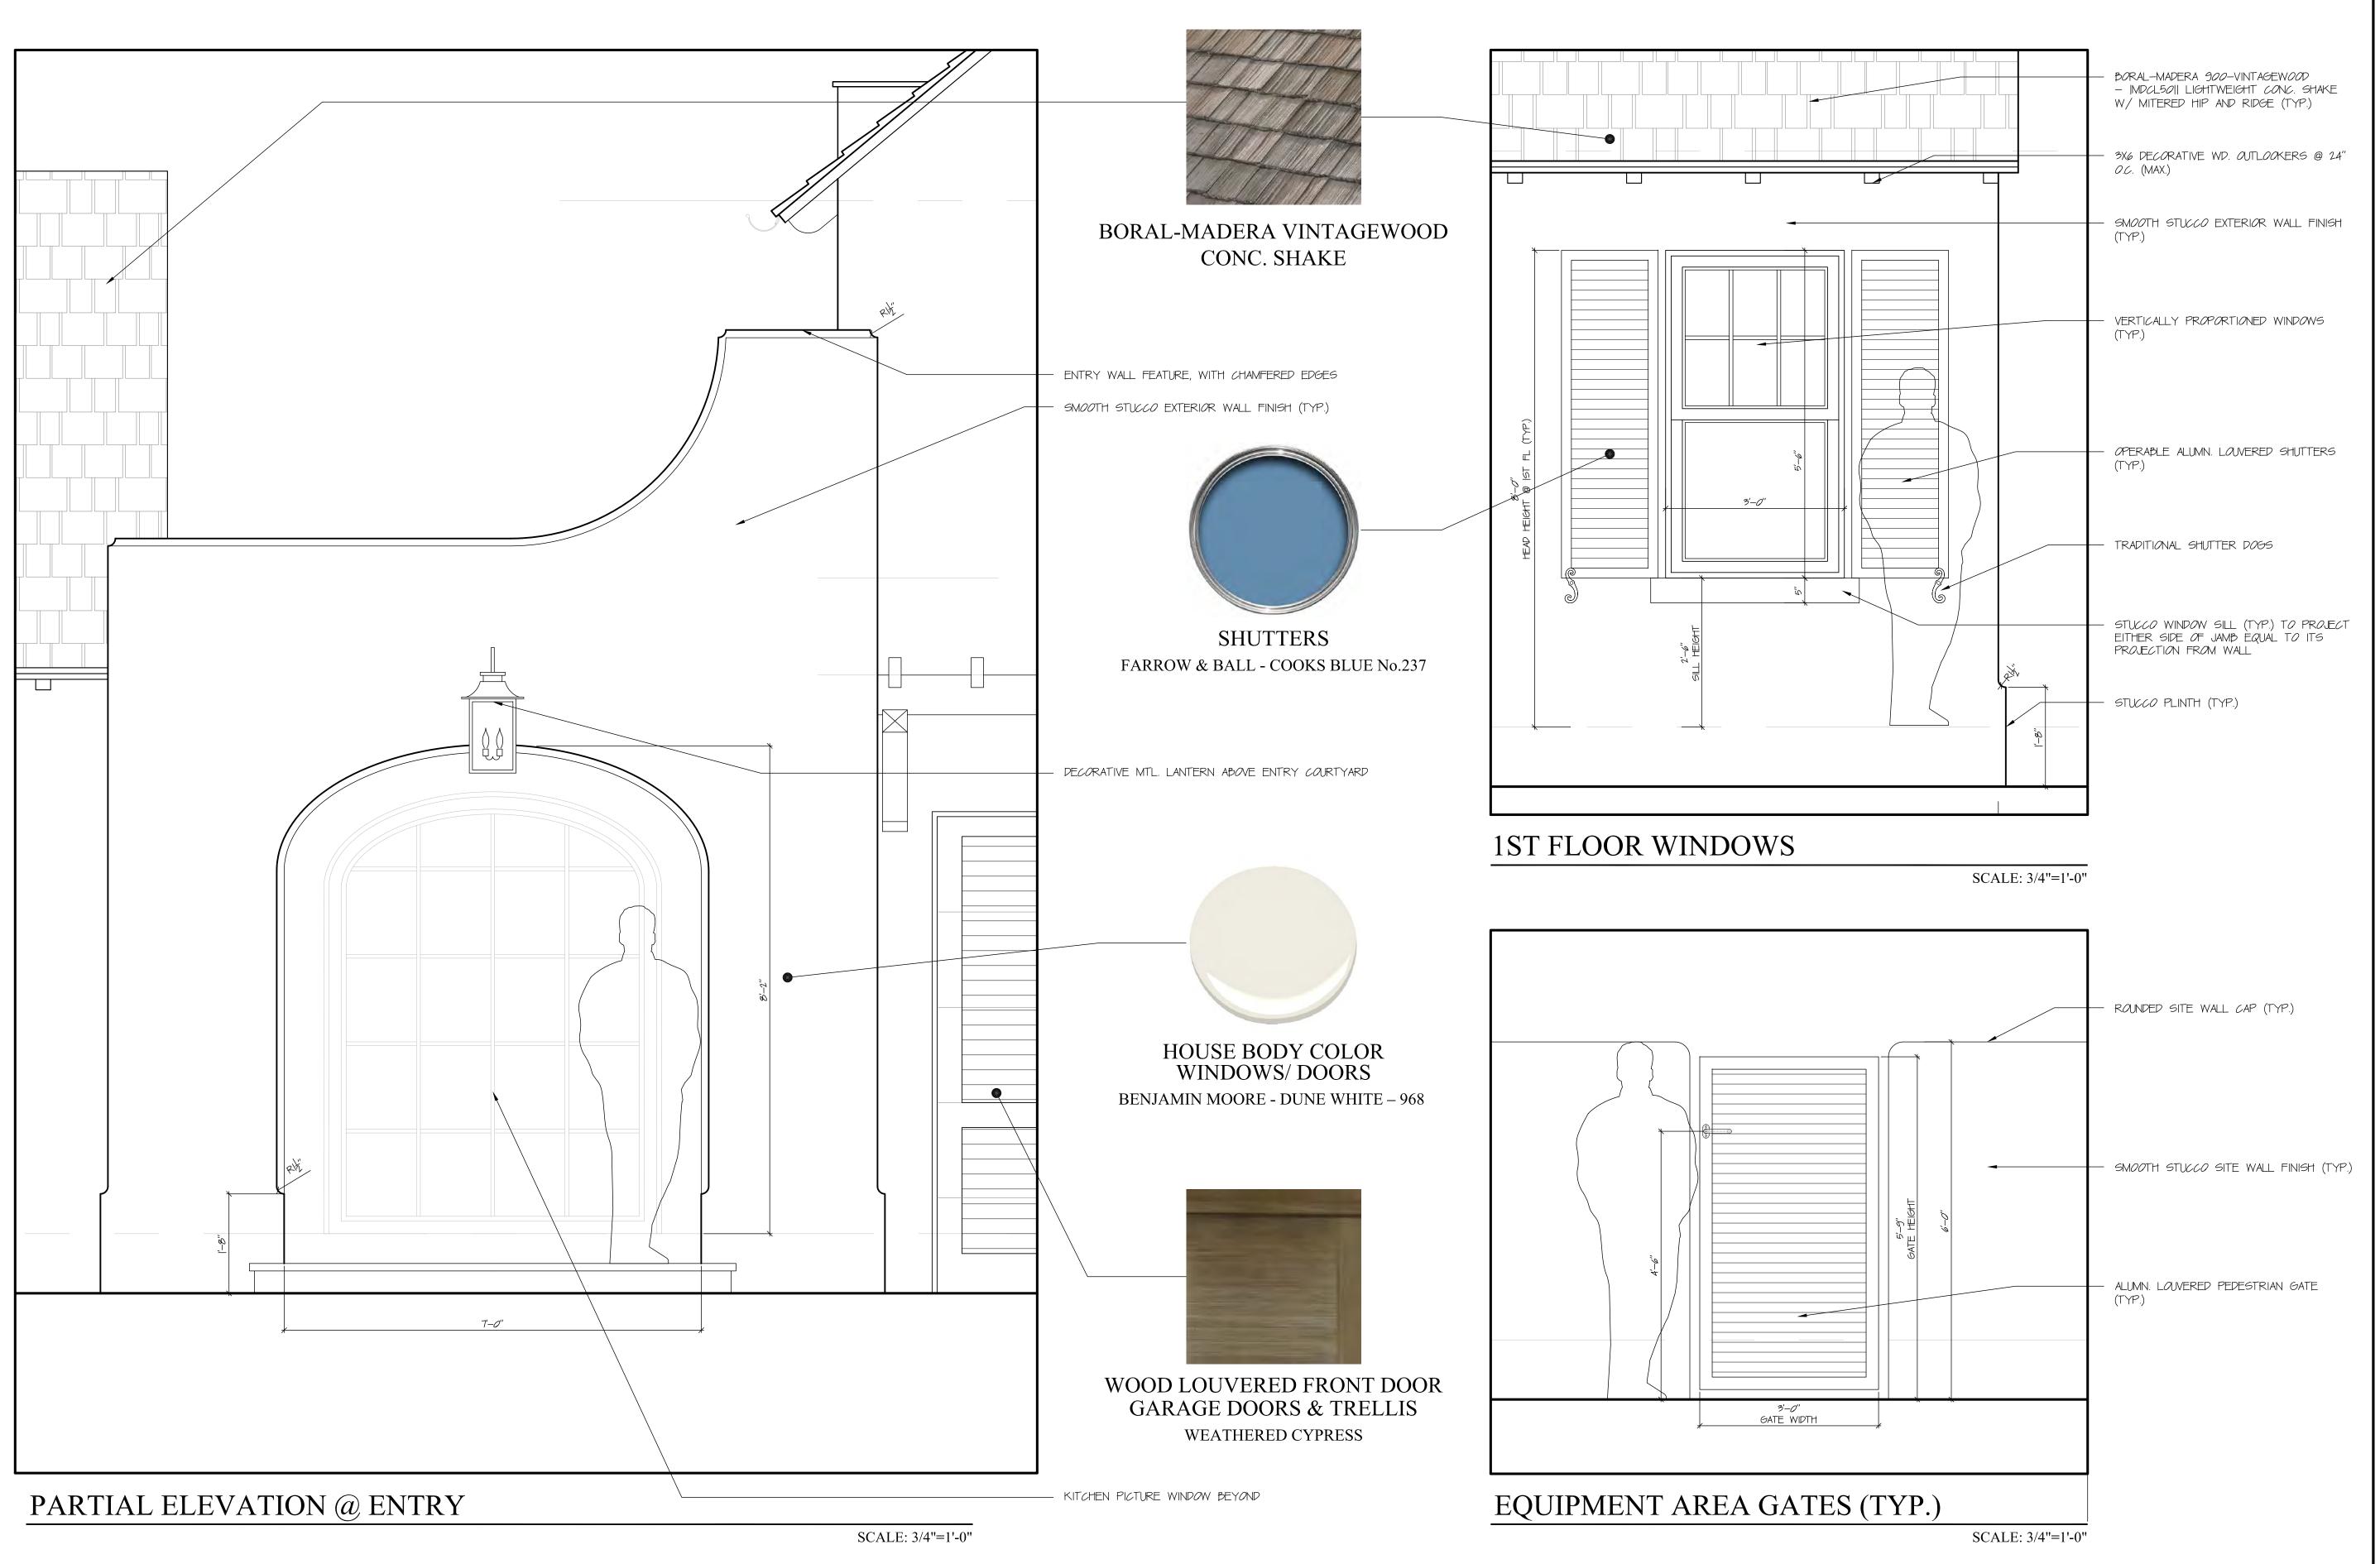

NEW RESIDENCE FOR
WILLIAMS AND SIRCHIO

FLORIDA AAC NO. 001285

HAROLD J. SMITH REGISTERED ARCHITECT 8742

JONATHAN C. MOORE REGISTERED ARCHITECT 13541

PETER G. PAPADOPOULOS REGISTERED ARCHITECT 92952

DANIEL KAHAN REGISTERED ARCHITECT 94757

 SCHEM. DESIGN
 2022-08-08

 SCHEM. DESIGN
 2022-08-26

 PRE-APP SUBMITTAL
 2022-09-19

 FIRST SUBMITTAL
 2022-11-07

 SECOND SUBMITTAL
 2022-11-28

 DROP-OFF SUBMITTAL
 2022-12-09

 DESIGN DEVELOP.
 2023-041-07

 DROP-OFF SUBMITTAL
 2023-05-08

ARC - 27-740 NO: 22026 DWG. BY: PGP SHEET:

DT-2



FLORIDA AAC NO. 001285

HAROLD J. SMITH REGISTERED ARCHITECT 8742

PETER G. PAPADOPOULOS REGISTERED ARCHITECT 92952

JONATHAN C. MOORE

REGISTERED ARCHITECT 13541


DANIEL KAHAN REGISTERED ARCHITECT 94757

PRE-APP SUBMITTAL 2022-09-1 DROP-OFF SUBMITTAL 2022-12-0 DESIGN DEVELOP. 2023-041-0 DROP-OFF SUBMITTAL 2023-05-08


NO: 22026 DWG. BY: PGP

SHEET:

SV-3

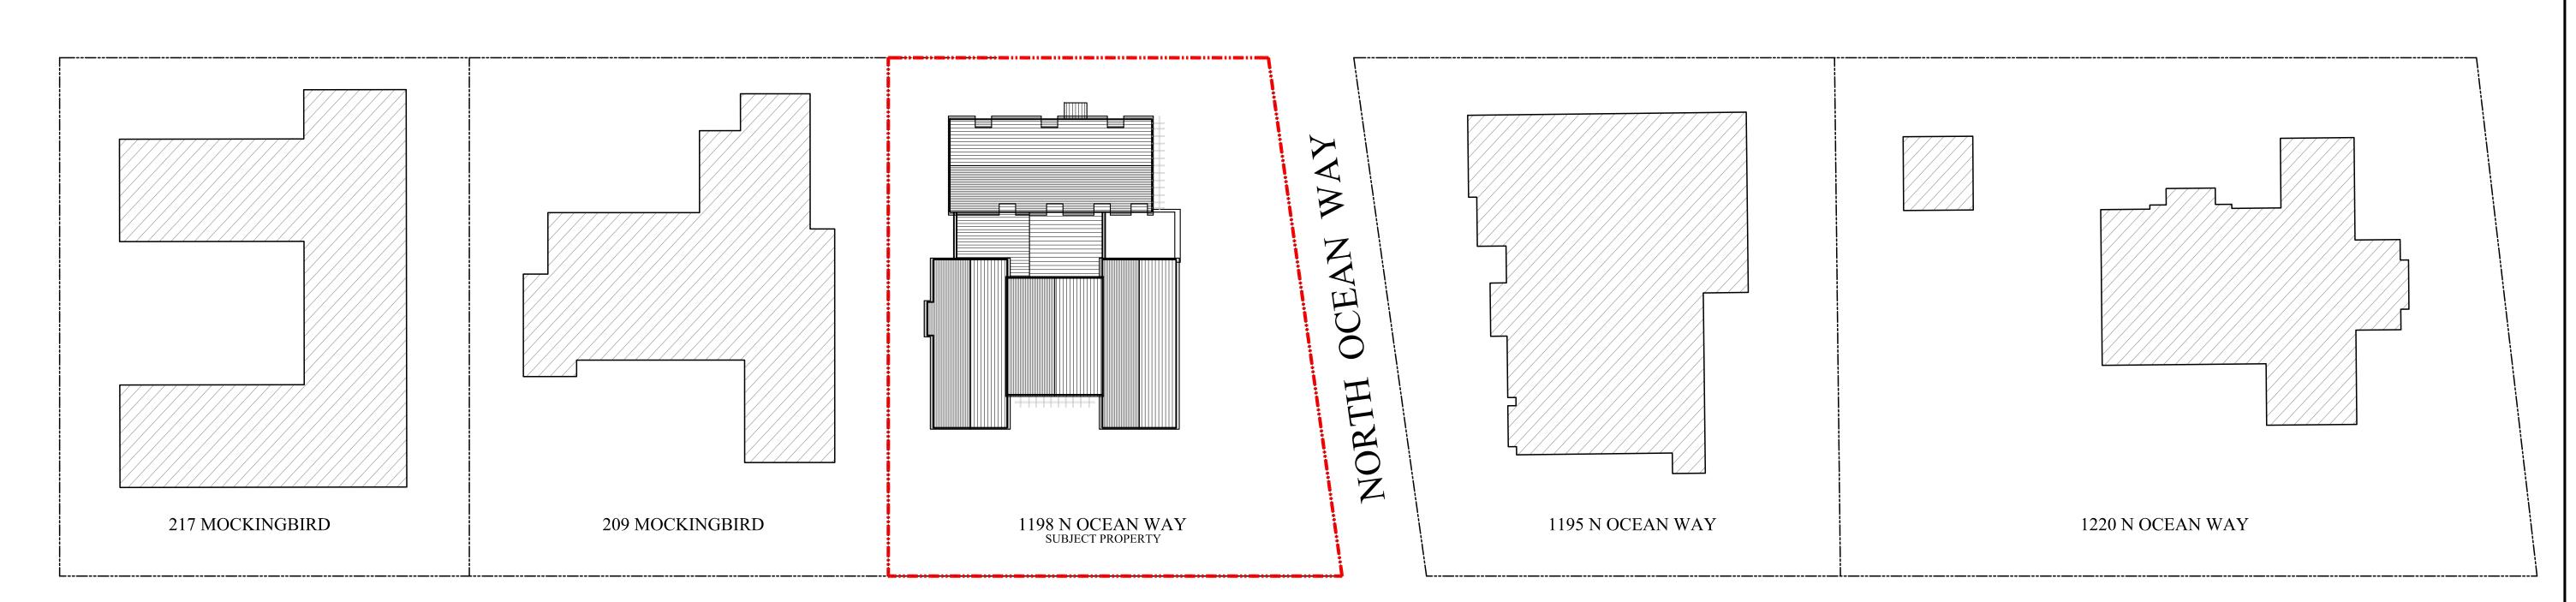

### MOCKINGBIRD TRAIL

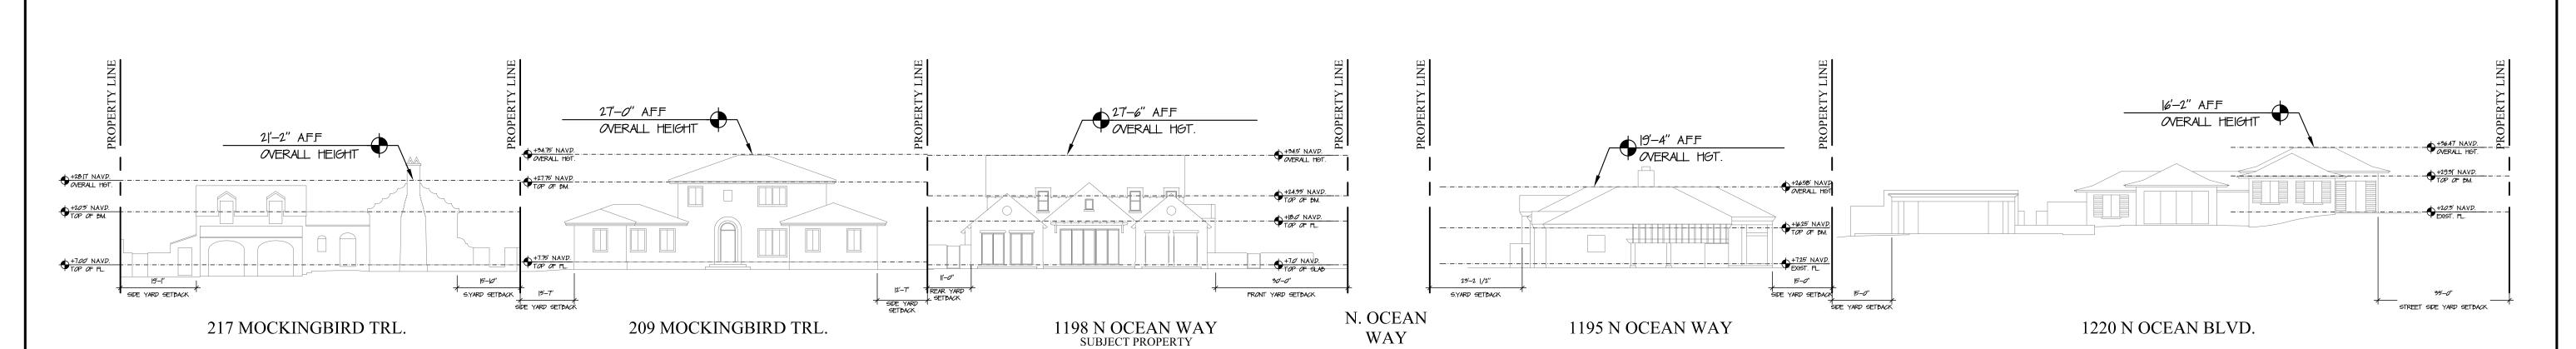


WAY

STREETSCAPE ELEVATION - LOOKING NORTH

NOT TO SCALE

STREETSCAPE PLAN

NOT TO SCALE

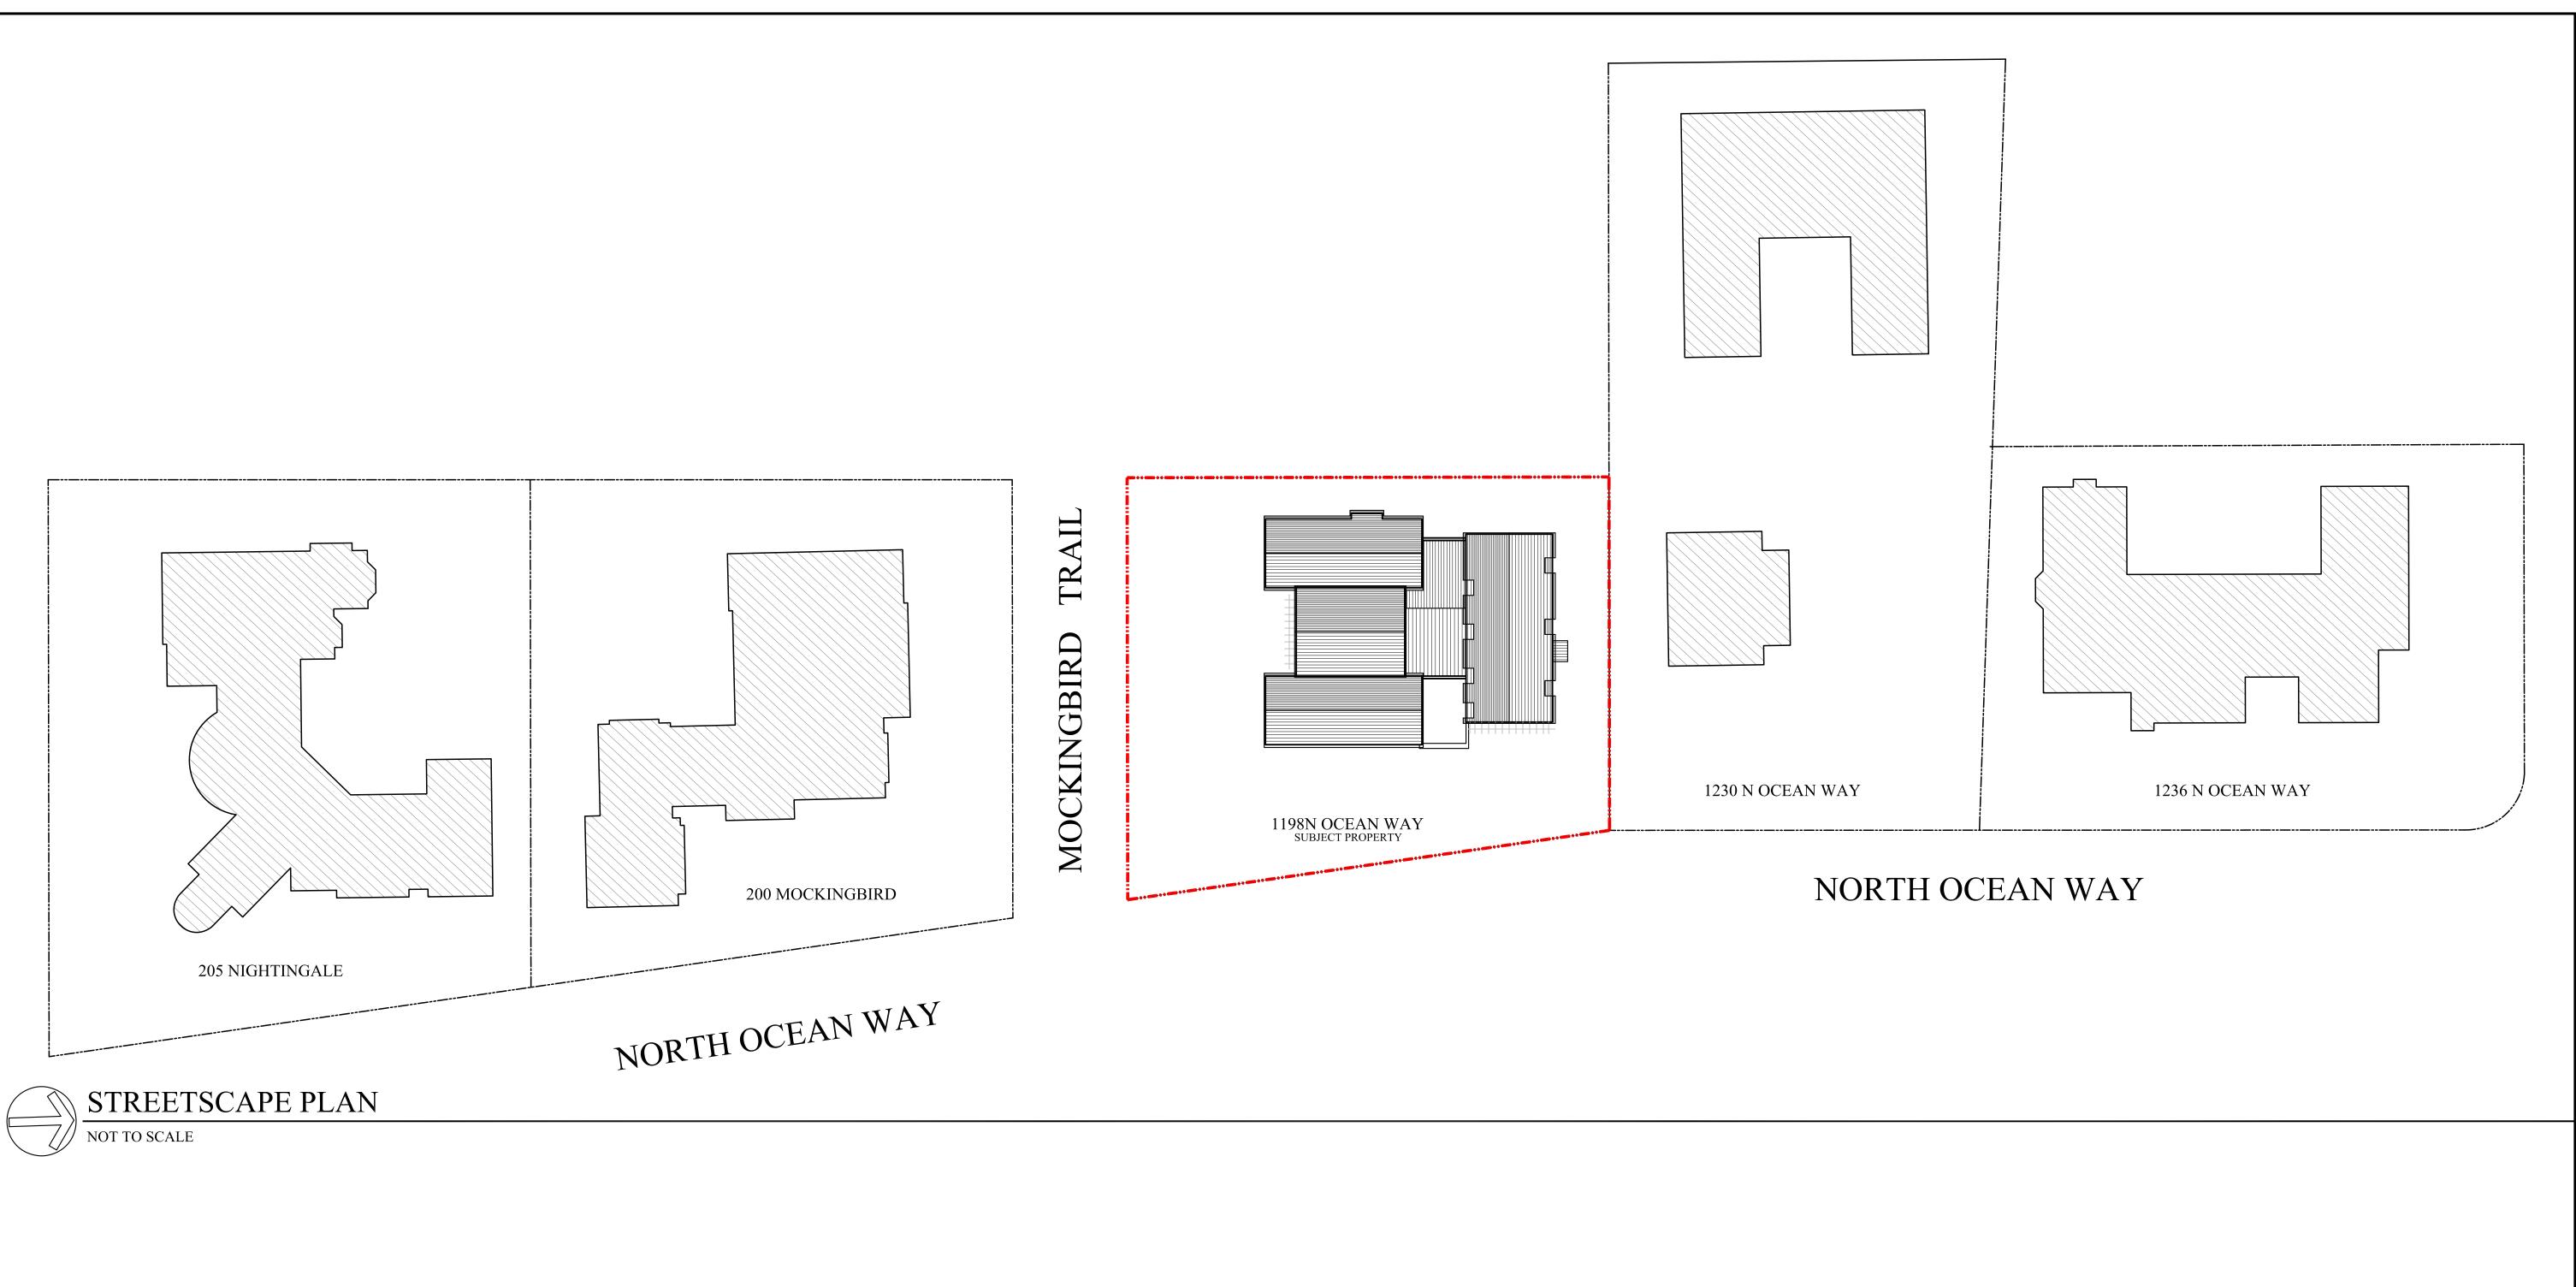

27'-6" A.F.F

1198 N OCEAN WAY SUBJECT PROPERTY

%-| |/2"

STREET SIDE YARD SETBACK

MOCKINGBIRD

TRAIL

OVERALL HEIGHT

170 NAVD.

170 OF SLAD

170 OF SLAD

170 OF SLAD

18-10'

19-10'

SDE YARD SETDACK

26'-|" A.F.F OVERALL HGT.

1230 N OCEAN WAY

FLORIDA AAC

NO. 001285

HAROLD I SMITH

 $\sum$ 

HAROLD J. SMITH REGISTERED ARCHITECT 8742 JONATHAN C. MOORE

REGISTERED ARCHITECT 13541

23'-6" AF.F OVERALL HGT.

1236 N OCEAN WAY

PETER G. PAPADOPOULOS REGISTERED ARCHITECT 92952

DANIEL KAHAN REGISTERED ARCHITECT 94757

 SCHEM. DESIGN
 2022-08-08

 SCHEM. DESIGN
 2022-08-26

 PRE-APP SUBMITTAL
 2022-09-19

 FIRST SUBMITTAL
 2022-11-07

 SECOND SUBMITTAL
 2022-11-28

 DROP-OFF SUBMITTAL
 2022-12-09

 DESIGN DEVELOP.
 2023-041-07

 DROP-OFF SUBMITTAL
 2023-05-08

NO: 22026
DWG. BY: PGP
SHEET:

SV-4

\ STREETSCAPE ELEVATION - LOOKING WEST

14'-0" AF.F OVERALL HGT.

205 NIGHTINGALE TRL.

+6.94' NAVD. EXIST. FL.


13'-7'
FRANT YARD SETBACK


NOT TO SCALE

26'-0" A.F.F

OVERALL HEIGHT  $\Psi$ 

200 MOCKINGBIRD TRL.

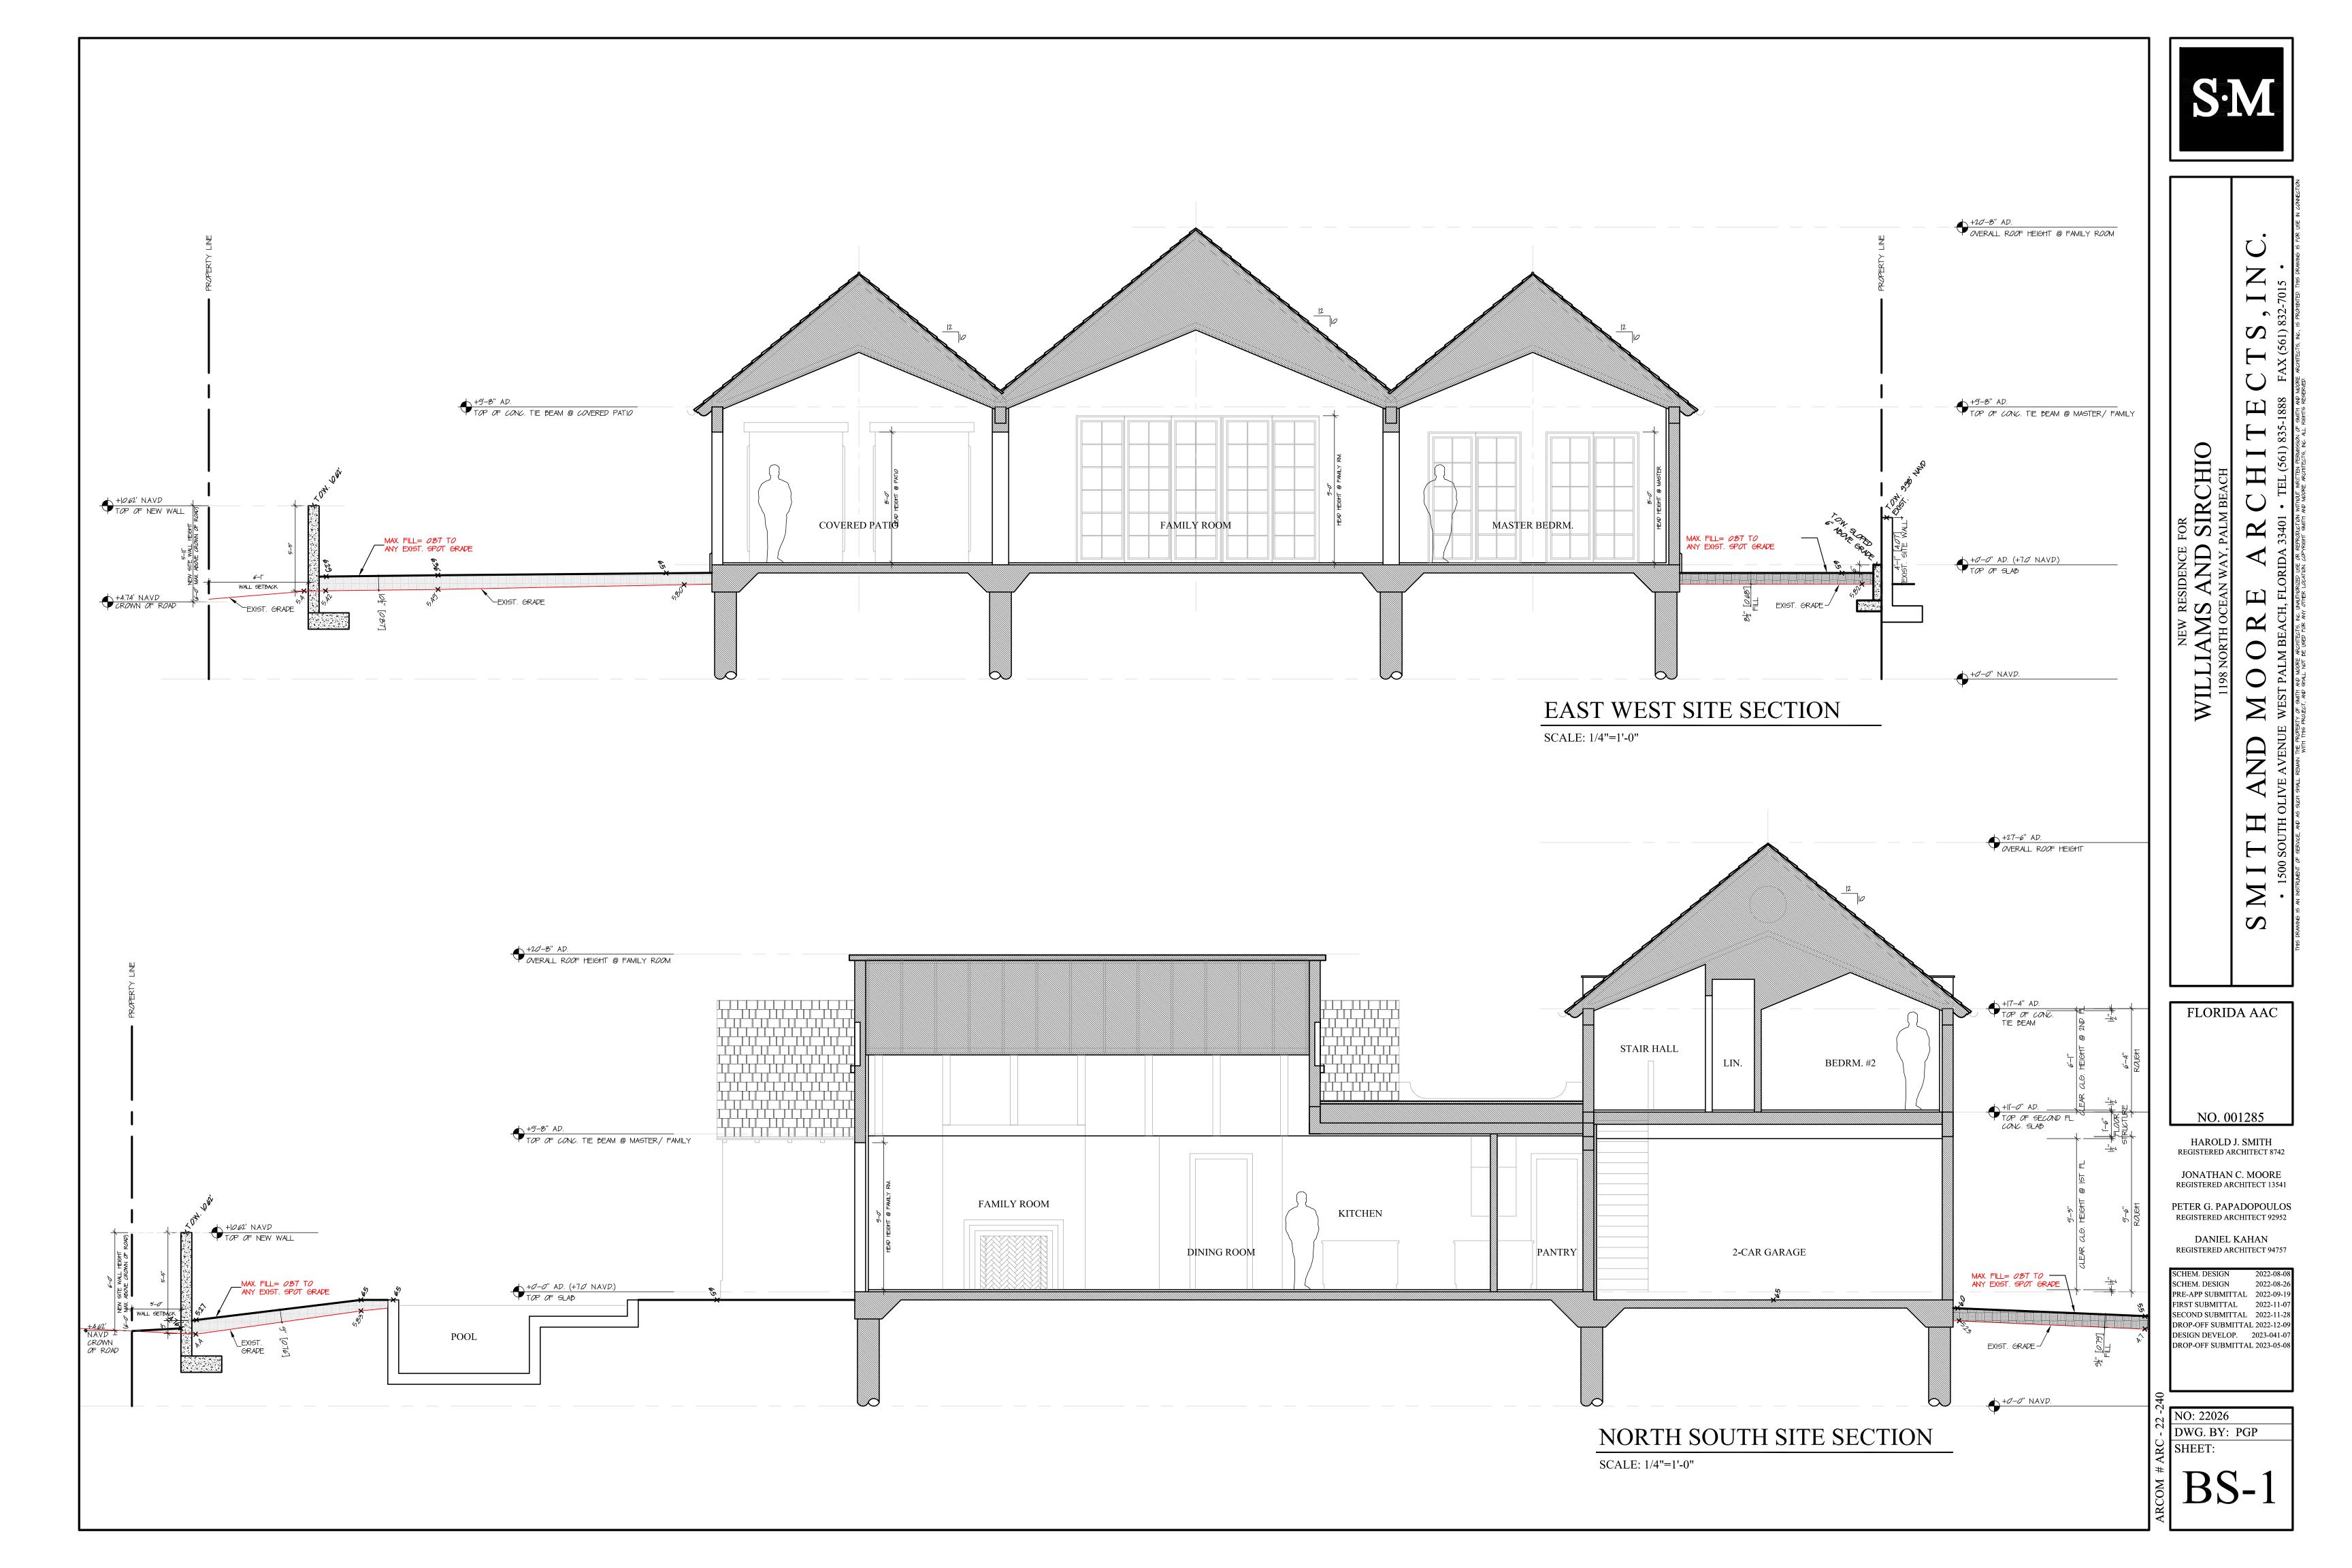

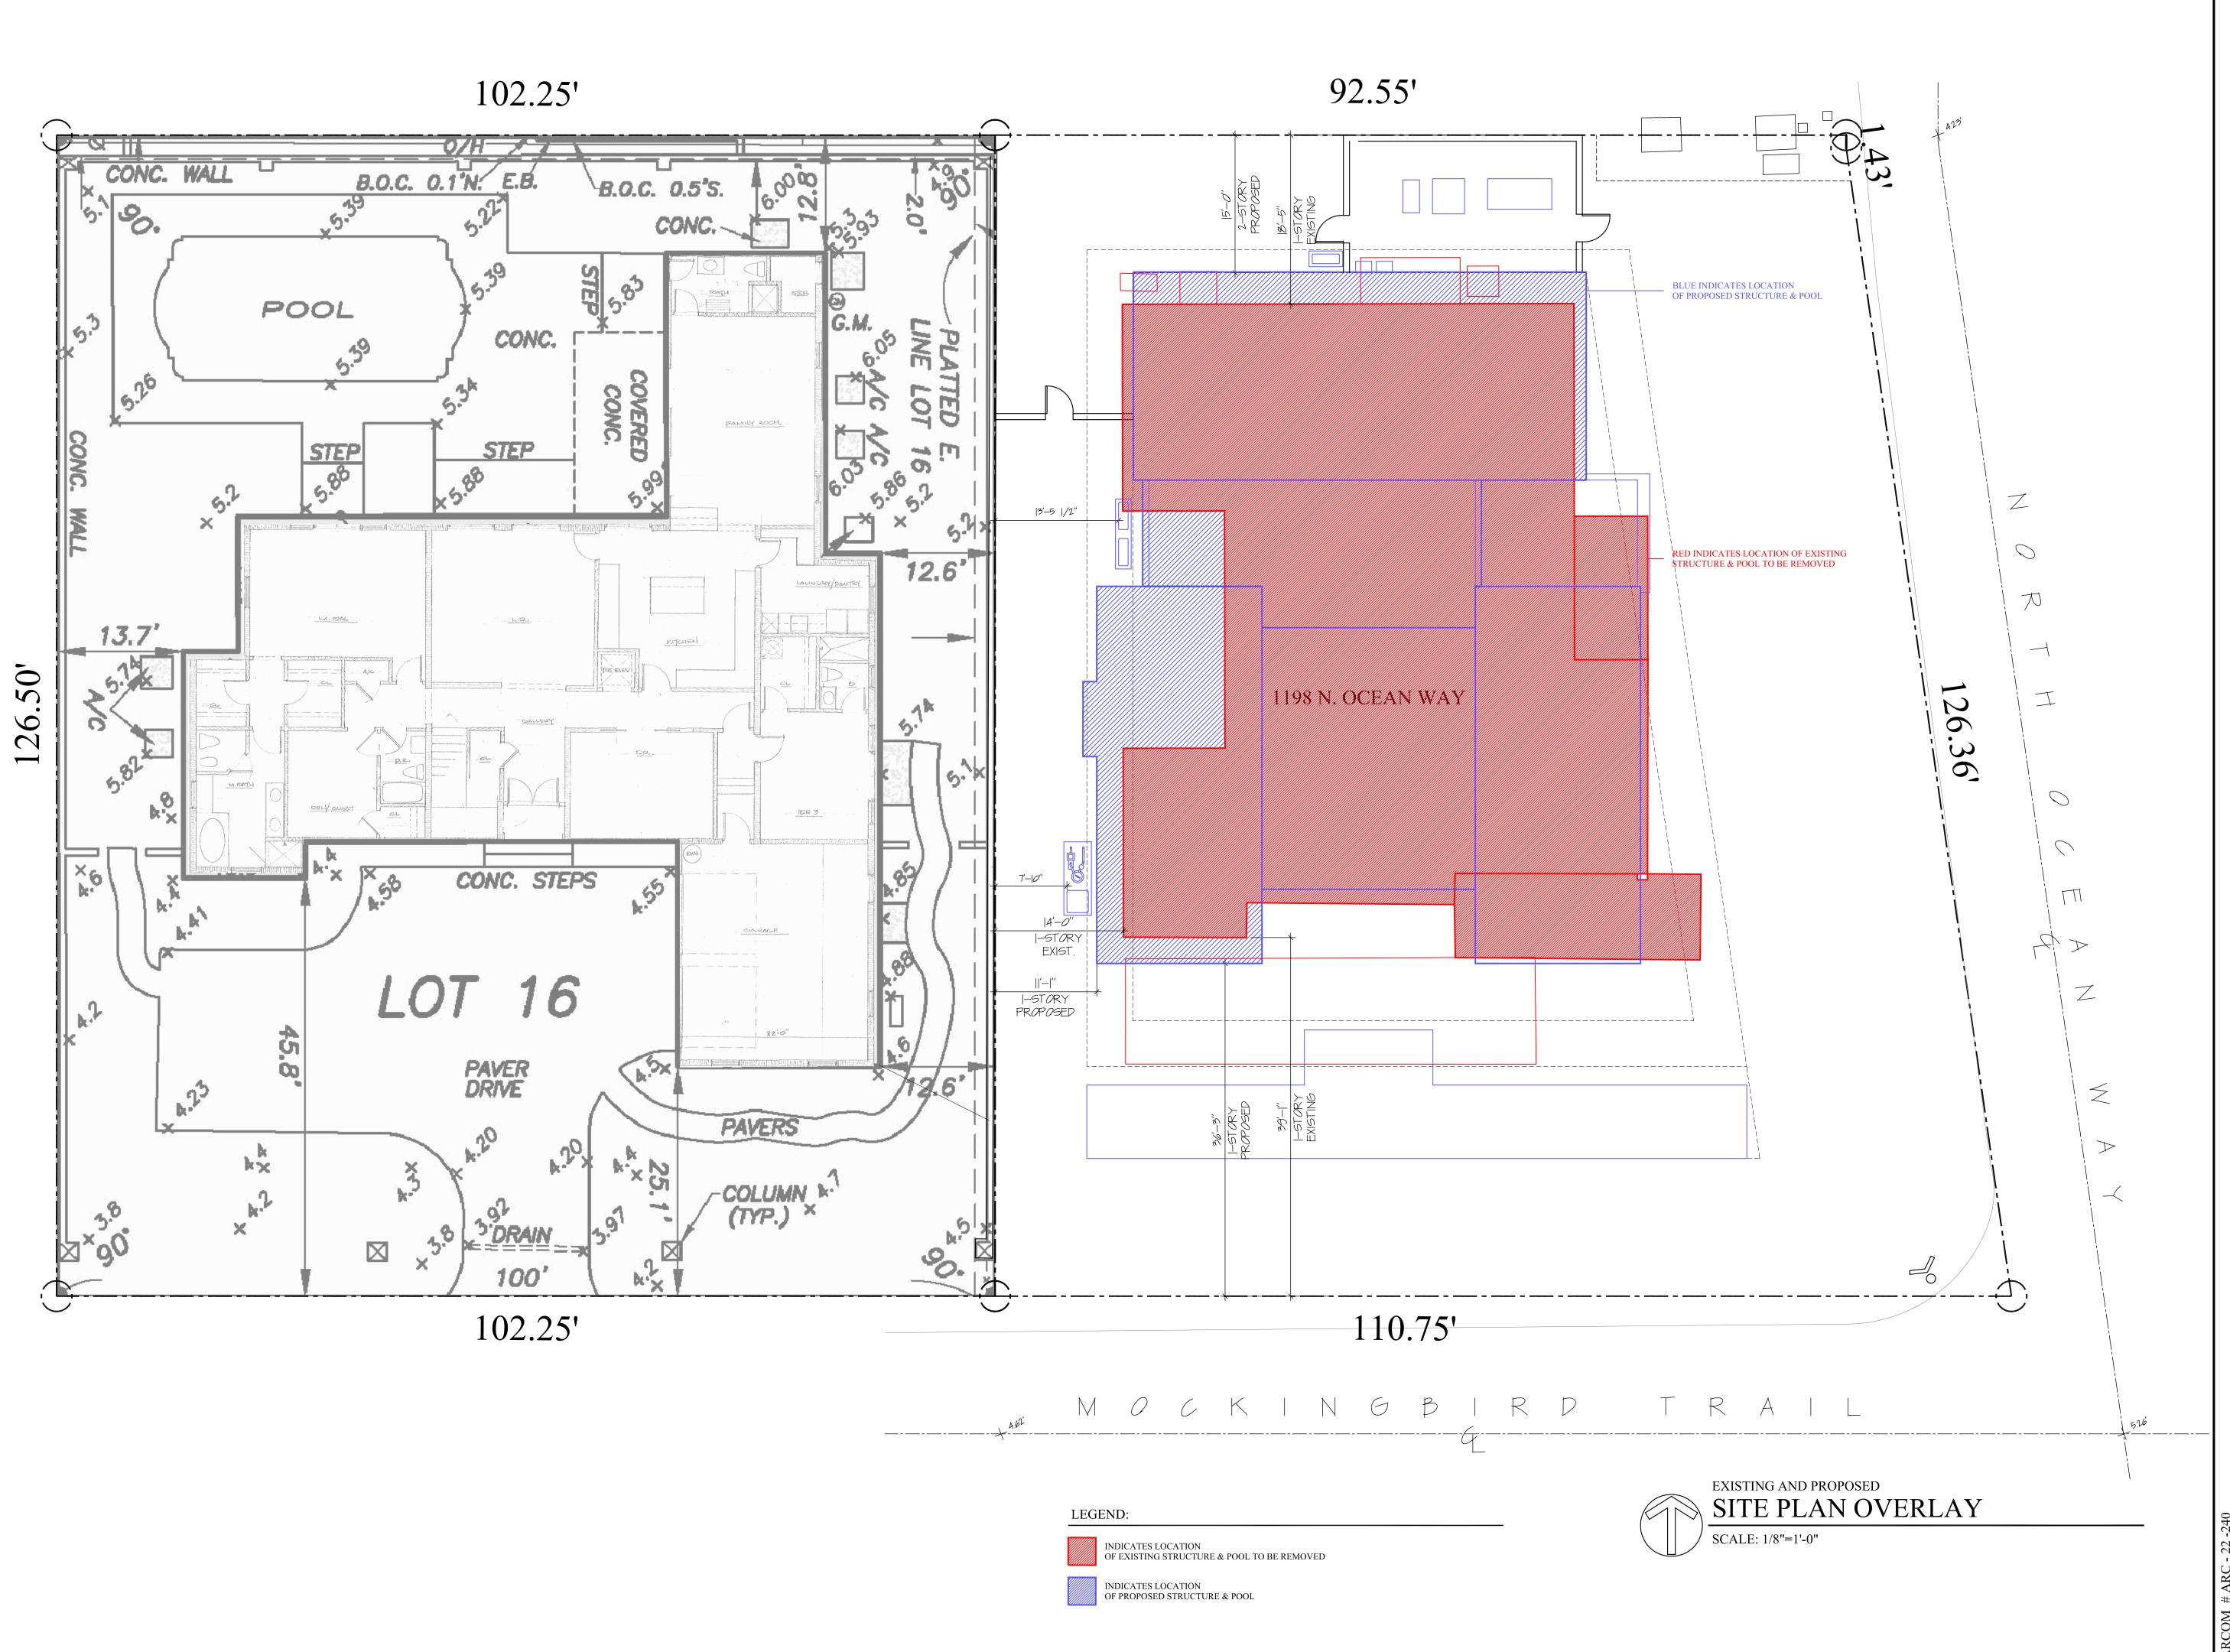



WILLIAMS AND SIRCHIO
HOSEAN WAY, PALM BEACH
AITH AND MOORE ARCHITECTS, IN

FLORIDA AAC

S

HAROLD J. SMITH REGISTERED ARCHITECT 8742

NO. 001285

JONATHAN C. MOORE REGISTERED ARCHITECT 13541

PETER G. PAPADOPOULOS REGISTERED ARCHITECT 92952

DANIEL KAHAN REGISTERED ARCHITECT 94757

 SCHEM. DESIGN
 2022-08-08

 SCHEM. DESIGN
 2022-08-26

 PRE-APP SUBMITTAL
 2022-09-19

 FIRST SUBMITTAL
 2022-11-07


 SECOND SUBMITTAL
 2022-11-28

 DROP-OFF SUBMITTAL
 2022-12-09

 DESIGN DEVELOP.
 2023-041-07

 DROP-OFF SUBMITTAL
 2023-05-08

NO: 22026 DWG. BY: PGP SHEET:

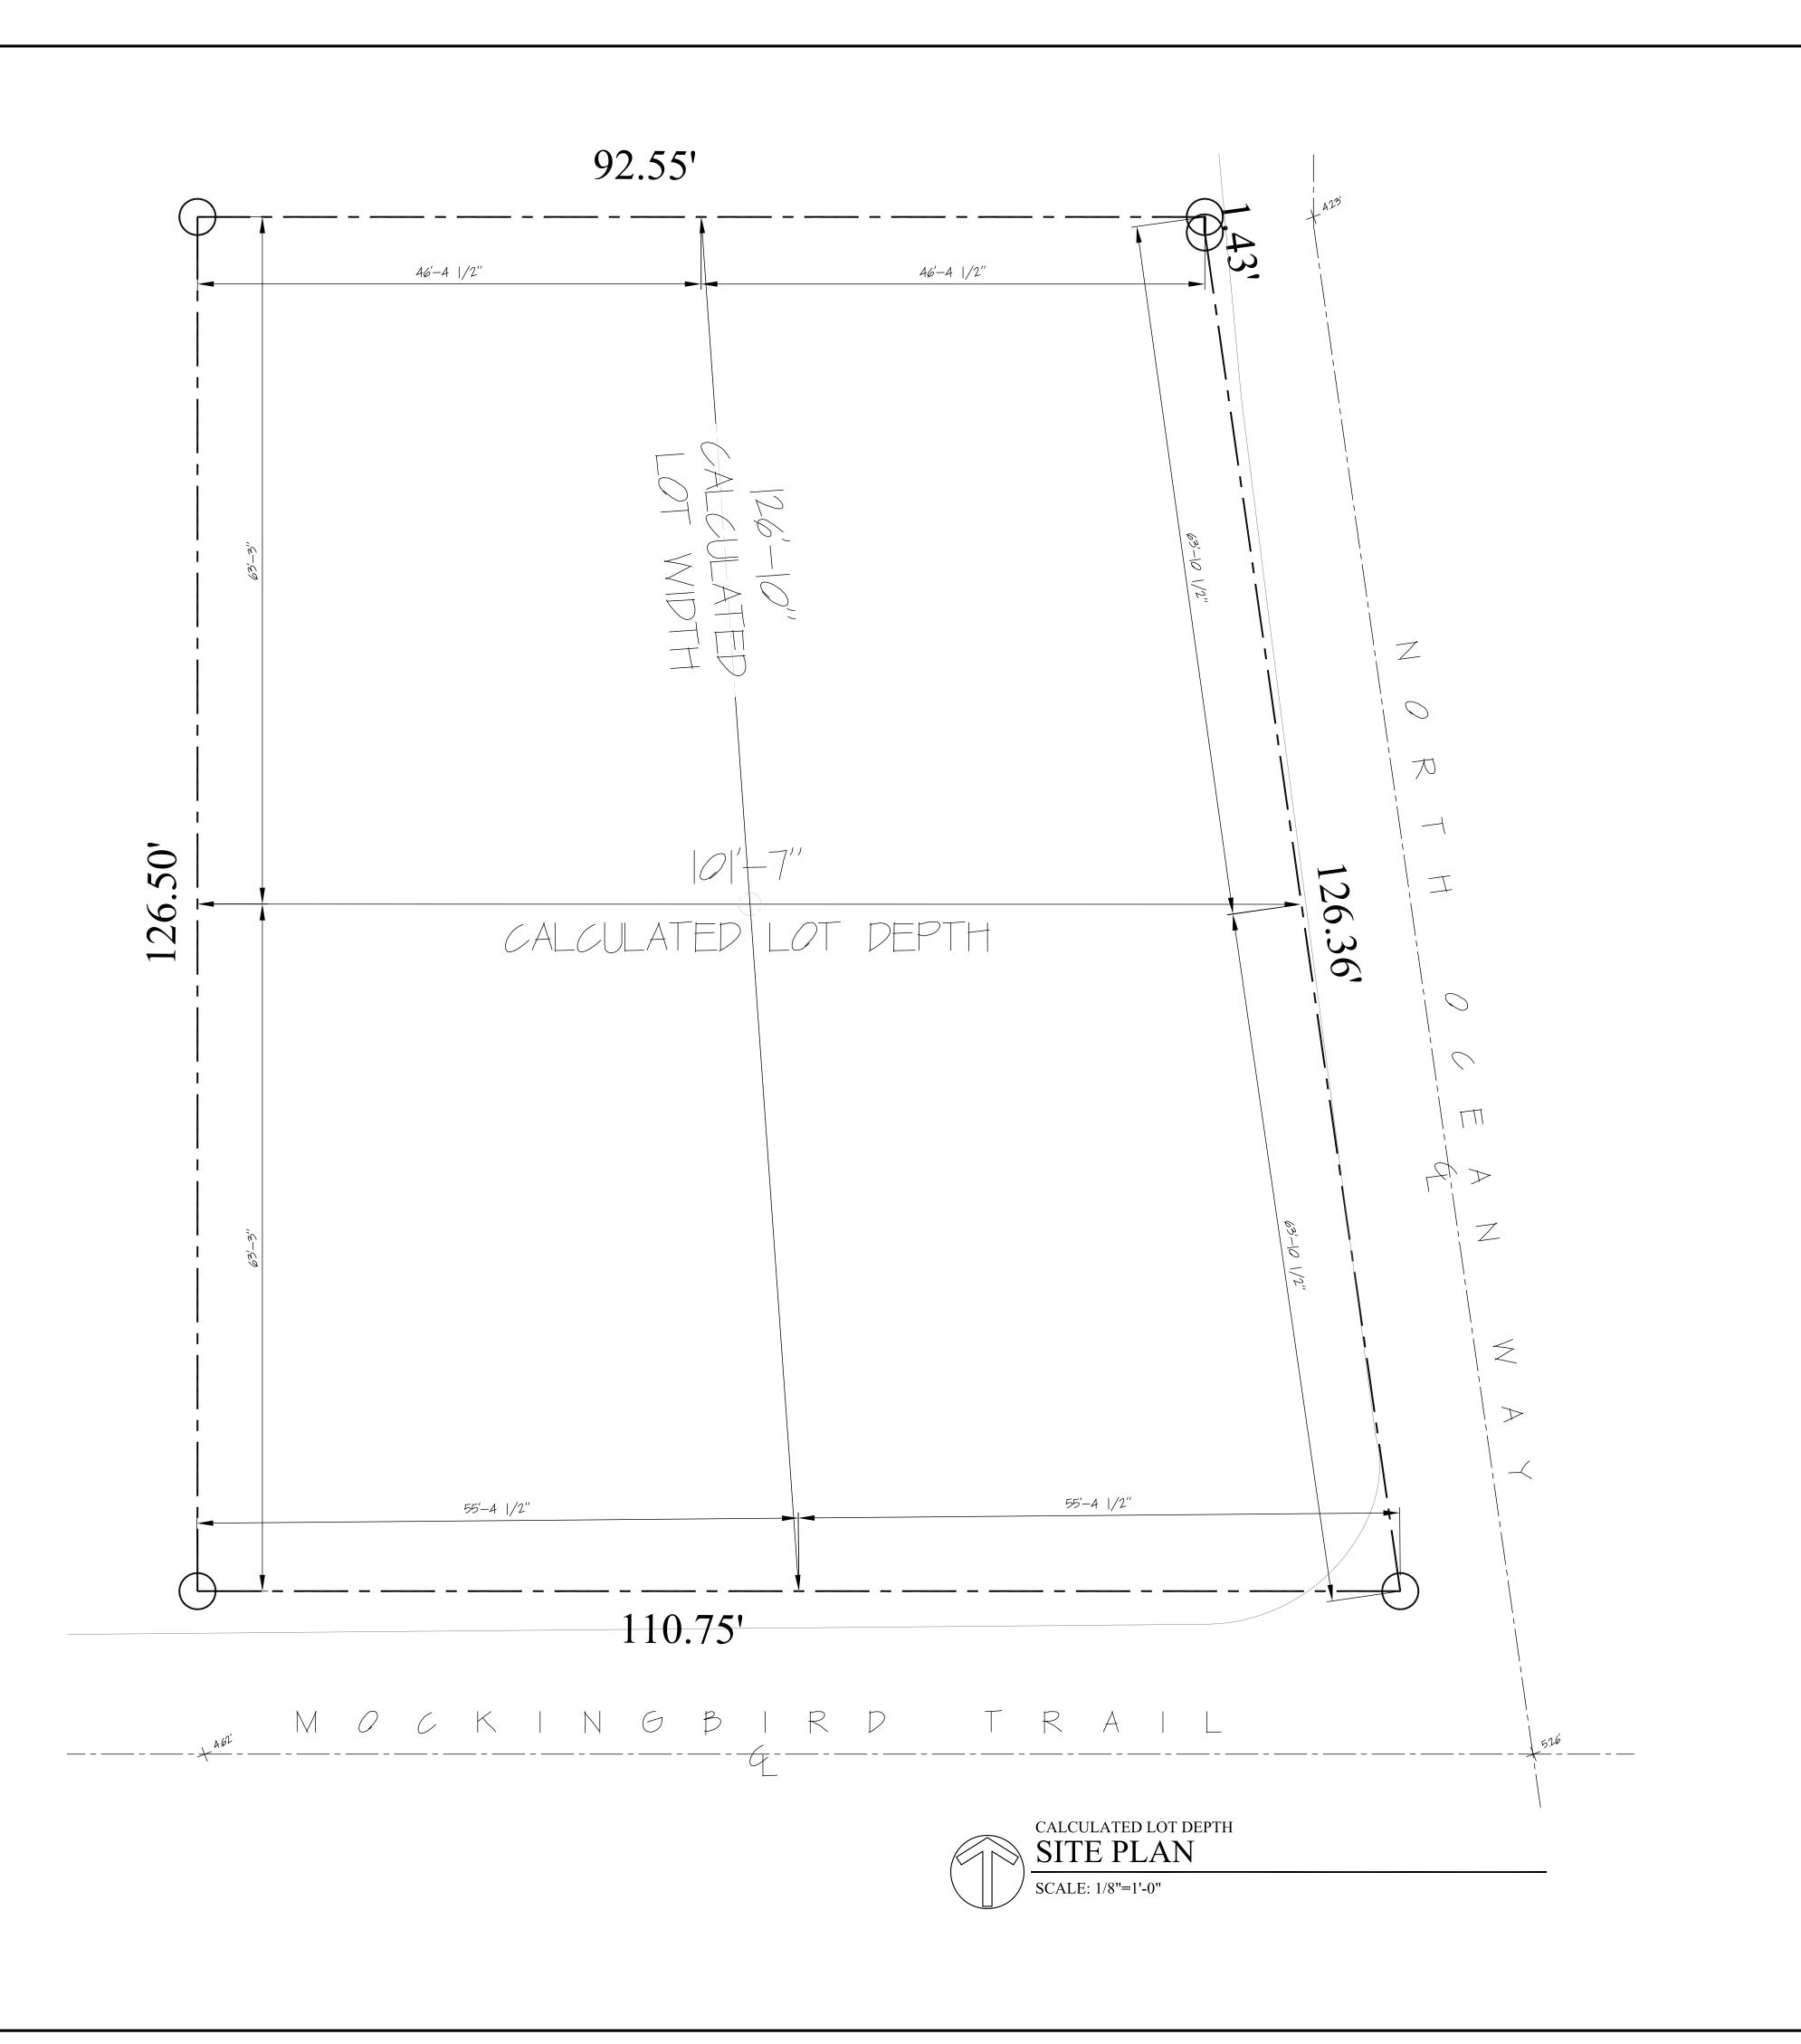



# WILLIAMS AND SIRCHIO ANTO O D E A D C LITE C T C

FLORIDA AAC

 $\vdash$ 

NO. 001285
HAROLD J. SMITH

REGISTERED ARCHITECT 8742

JONATHAN C. MOORE

REGISTERED ARCHITECT 13541

PETER G. PAPADOPOULOS

REGISTERED ARCHITECT 92952

DANIEL KAHAN REGISTERED ARCHITECT 94757

 SCHEM. DESIGN
 2022-08-08

 SCHEM. DESIGN
 2022-08-26

 PRE-APP SUBMITTAL
 2022-09-19

 FIRST SUBMITTAL
 2022-11-07

 SECOND SUBMITTAL
 2022-11-28

 DROP-OFF SUBMITTAL
 2022-12-09

 DESIGN DEVELOP.
 2023-041-07

 DROP-OFF SUBMITTAL
 2023-05-08

NO: 22026 DWG. BY: PGP SHEET:

SP-LI